


Section 28 Township 10 Range 23W

Well No. #8 Steve Nenechek

Company Magnolia

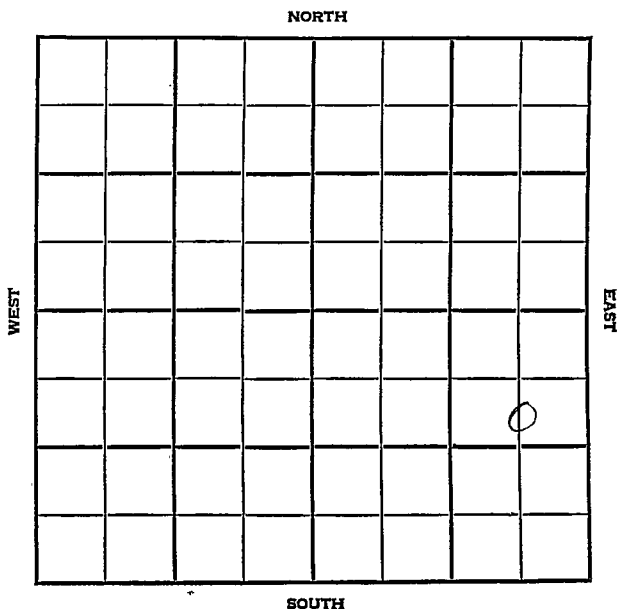

County Graham Elev. _____
 Sec. 28 Twp. 10 Rge. 23W
 Company Magnolia
 FarmName Steve Nenechek No. 8

Co.

TOPS	DEPTH	LOG	DATUM
Anh.			
Tp.			
H.			
Tr.			
Dg.			
Bl.			
L.			
K.C.			
B.K.C.			
Ce.			
C.			
M.			
M.			
K.			
Mz.			
Me.			
V.			
S.			
S.			
A.			
R.			
PE.			
G.			
T.D.			

Loc. in Sec. S/2 NE SE

Geol. _____
 Contr. _____
 Brack Tools _____
 Pool _____
 Diebolt _____

Lse.

FIRST REPORT
 OCT 24 1956

No.

Date Comm. _____
 Location _____

2709 - S VOM

U R

County Graham Elev. 2369
 Sec. 28 Twp. 10 Rge. 23W
 Company Magnolia
 Farm Name Steve Nenechek No. 8

TOPS	DEPTH	LOG	DATUM	Loc. in Sec.
Anh.				S/2 NE SE
TP.				
H.	3578			
Tr.	3600			
Dg.				
Bl.				
L.				Geol.
K.C.	3613			Contr.
R.K.C.	3843			Brack Tools
Ce.				Pool
C.				Diebolt
M.				
M.				
K.				
Mz.				
Me.				
V.				
S.				
S.				
A.				
R.				
PE.				
G.				
TD.	3880			

NOV 23 '56
COMPLETE

Date Comm. NOV 31 '56
 Location 10 - 25 - 56
95/8 359/275 ID 2690 NOV 7 '56
DST 3768-85 1hr 1200' gas
see 80' ch. oil + 130' HOCM
BHP 470/20" 5 1/2 3879/ NOV 13 '56
CO 56/3814-22 / 3779-85 ID
1 Plat' oph B \$ 64 B0 + 12
B acid. wt. 3 hrs 1st P. 59
B0 + 7 B acid w 2 hrs NOV 21 '56

P. 124 Bopd + 8% wt
grain 41.3°