


Graham KANSAS

DX 78-1

Section 28 Township 10 Range 23W  
Well No. 2 Wickizer  
Company Wickizer

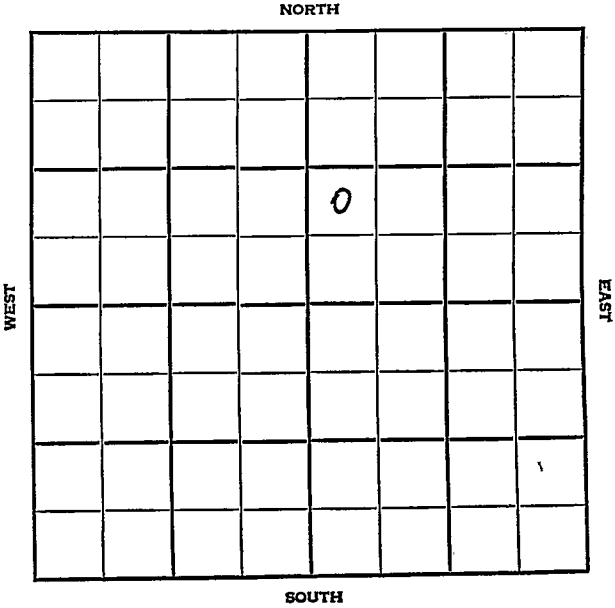

Graham KANSAS

SEC.	TWP.	R.
28	10	23W

WELL NO.

2 Wickizer

FARM


COMPANY

Wickizer

CONTRACTOR

Wickizer

\_\_\_\_\_ Ft. from N. Line  
 990 \_\_\_\_\_ Ft. from S. Line  
 \_\_\_\_\_ Ft. from E. Line  
 330 \_\_\_\_\_ Ft. from W. Line

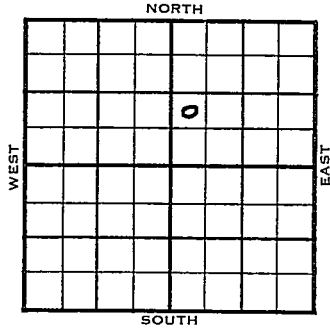

NW SW NE

1954	ELEVATION 2382'	REPORT
------	--------------------	--------

7/7- M I R  
 7/21 KC 3639'  
 Drlg. 3643'  
 8/11 TD 3865'  
 5" @ 3863'  
 CO to 3861'  
 40/3847-54 1 boph 1 1/4 hrs., 3000A  
 S/33 boph  
 9/29 Spud 7-5-54  
 Oil Well  
 TD 3865'  
 8" @ 208'  
 KC 3639',  
 TD 3865'  
 5" @ 3863'  
 CO to 3861'  
 40/ 3847-54 1 boph 1 1/4 hr.  
 3000 A S/ 33 boph  
 Comp BHB 656 Bopd.

**COMPLETED**



