


Section 28 Township 10 Range 23 W

Well No. # 3 Nemechek

Company Lario

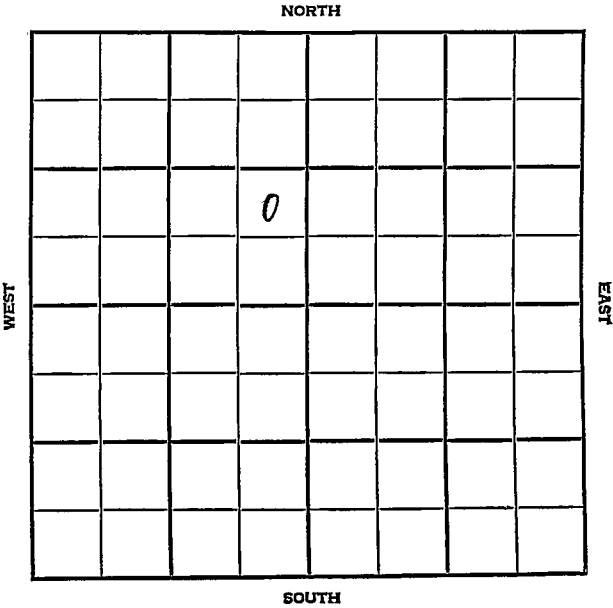

Graham

KANSAS

SEC.	TWP.	R.
28	10	23 W
WELL NO.		
# 3 Memechek		FARM
COMPANY		
Lario		
CONTRACTOR		

Transit

SE Happy Pool


Ft. from N. Line

990 Ft. from S. Line

330 Ft. from E. Line

Ft. from W. Line

NE SE NW

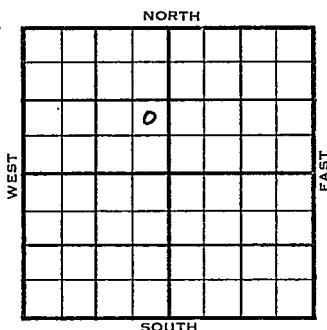

ELEVATION

REPORT

1954

2382'


8/11

Spud 8-9-54
8" @ 231 WOC

9/8

Spud 8-9-54 Oil well TD 3905
 8" @ 231 Heeb 3603 Lans 3637
 DST 3772-92 open 1 hr rec 35' GCWM
 800#
 DST 3794-3810 open 1 hr rec 2100'
 oil 550#
 DST 3809-30 open 1 hr rec 30' SO &
 SGCM 200#
 DST 3829-48 open 1 hr rec 270' gas
 150' VHO & GCM 500#
 DST 3850-70 open 1 hr rec 460' gas,
 95' HO & GCM TD 3905 5" @ 3905
 8/3807-08 dry 1000 A S/17 BOPH
 Comp. 397 BOPD

COMPLETED

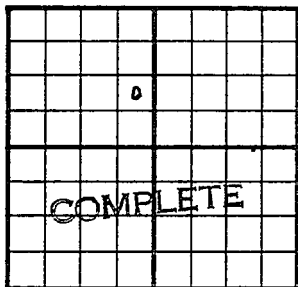County Graham State KansasSec. 28 (Blk. Twp.) 10 (Sur. Rge.) 23W Map No.Operator LarioWell No. 3 Farm NemechekElev. 2382 Location NE SE NW990 Ft. From S Line NW330 Ft. From E Line Quarter

1st. Report

Completion SEP 8 1954Remarks SE Happy PoolTransit - Contr.Spudding Date 8-9-54Drlg. Data Oil well TD 39058" @ 231 H_eb. 3603 Lans 3637DST 3772-92 open 1 hr. Rec. 35' gcwm800# DST 3794-3810 open 1 hr. Rec.2100' oil 550# DST 3809-30 open 1 hr.Rec. 30' so & sgcm 200# DST 3829-48open 1 hr. Rec. 270' gas 150' who & gcm500# DST 3850-70 open 1 hr. Rec.460' gas 95' ho & gcm TD 3905 5" @3905 8/ 3807-08 dry 1000 A S/ 17 bophComp. 397 bopd

FABEN GILSTRAP