


DX 78-1

Graham KANSAS

Section 28 Township 10 Range 23W

Well No. 2 Wickizer "B"

Company Hall-Wickizer

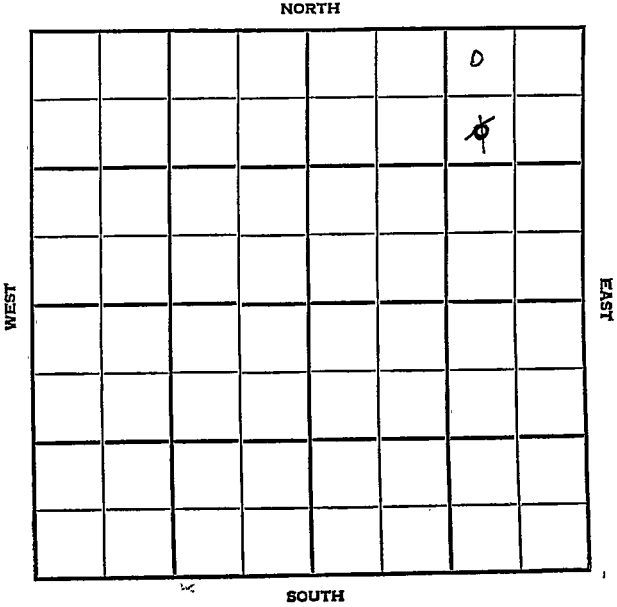

Graham KANSAS


SEC.	TWP.	R.
28	10	23W

WELL NO. **2 Wickizer "B"** FARM

COMPANY **Hall-Wickizer**

CONTRACTOR **Wickizer**  
**SE Happy Pool**

~~990~~ **330** Ft. from N. Line  
 \_\_\_\_\_ Ft. from S. Line  
**990** Ft. from E. Line  
 \_\_\_\_\_ Ft. from W. Line

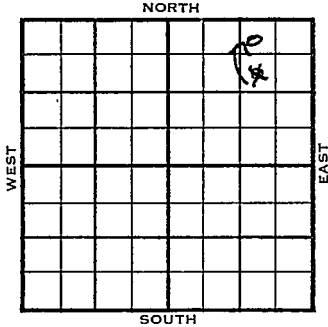

NW  
SW NE NE

1955	ELEVATION 2371'	REPORT
------	--------------------	--------

1/26 Spud 1-20-55  
 10" @ 355'  
 rlg. 2800'

2/16 Spud 1-20-55  
 10" @ 355'  
 Heeb 3618' KC 3651' B KC 3880'  
 TD 4088'  
 D & A

**ABANDONED**





