


Section 28 Township 10 Range 23 W

Well No. #5 Wickizer

Company Wick Pet.

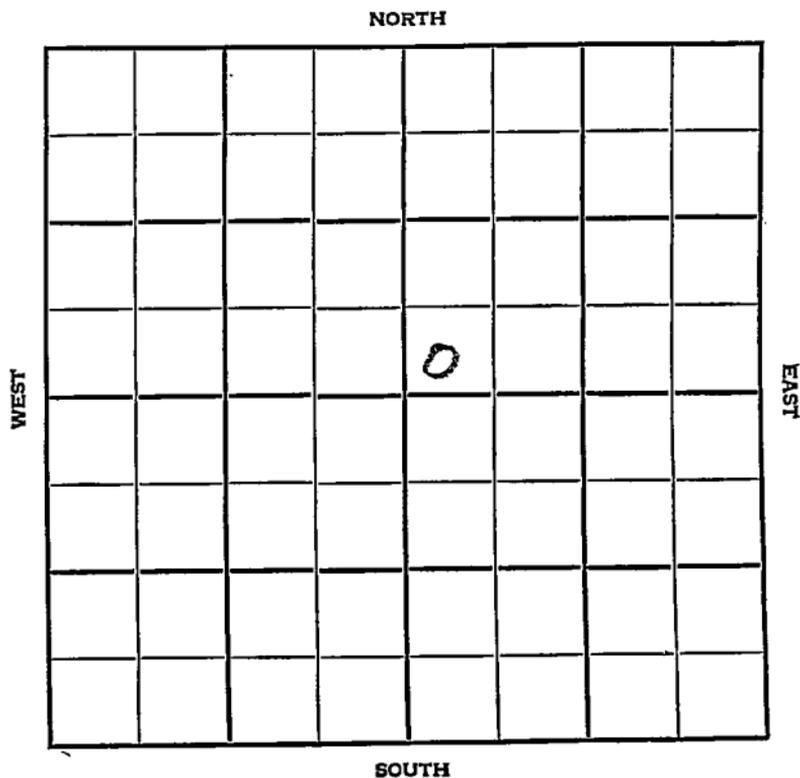

Graham

KANSAS

SEC. 28	TWP. 10	R.. 23W
------------	------------	------------

WELL NO.

#5 Wickizer

FARM

COMPANY

Wick Pet.

CONTRACTOR

Co. Tools


Happy

_____ Ft. from N. Line

_____ Ft. from S. Line

_____ Ft. from E. Line

_____ Ft. from W. Line

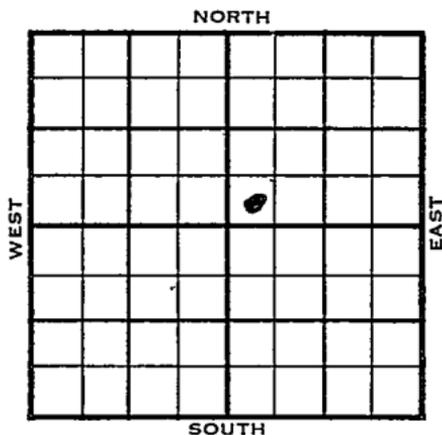

SW SW NE

1955

ELEVATION
2379'

REPORT

7/20

Comm: 7-12-55
8" @223/175
Drlg. 3312

8/3

Comm 7-12-55
Anh 1900, H 3598, L 3633,
TD 3900
8" @ 223/175 DST 3635-60 open 1
hr. Rec 200' GIP 205' gas & ocm
600' sw 1050/20" DST 3781-3802 open
1 hr Rec 15' mud 0/20" DST 3802-24
open 1 hr Rec 20' mud 0/20" DST
3824-70 open 1 hr 600' GIP Rec 185'
msw 390/20" TD 3900
D & A

ABANDONED

County Graham Elev. 2379

Sec. 28 Twp. 10 Rgr. 23W

Company Wick Pet.

Farm Name Wickizer No. 5

TOPS	DEPTH	LOG	DATUM
Anh.			
TP.			
H.			
Tr.			
Dg.			
Bl.			
L.			
K.C.			
B.K.C.			
Ce.			
C.			
M.			
M.			
K.			
Mz.			
Mo.			
V.			
S.			
S.			
A.			
R.			
PE.			
G.			
T.D.			

Loc. in Sec. SW SW NE

Geol. _____

Contr. _____

Co. tools _____

Pool _____

~~Happy~~

JUL 20 1955
0
FIRST REPORT

Date Comm. 7-12-55

8" @ 223/175 drlg. 3312

[Handwritten signature]

Co.

Use.

No.

Sec.

T.

R.

County Graham Elev. 2379 Co. Co.
 Sec. 28 Twp. 10 Rge. 23W
 Company Wick Pet.
 Farm Name Wickizer No. 5

TOPS	DEPTH	LOG	DATUM
Anh.	1900		
Tr.	3598		1219
L.	3633		1254
TD.	3900		1521

Loc. in Sec. SW SW NE
 Geol. _____
 Contr. _____
 Co. tools _____
 Pool Happy

ABANDONED

Date Comm. 7-12-55 AUG 3 1955
 8" @223/175 DST 3635-60 open 1 hr.
 Rec. 200' GIP 205' gas & ocm 600' sw
 1050/20" DST 3781-3802 open 1 hr.
 Rec. 15' mud 0/20" DST 3802-24
 open 1 hr. Rec. 20' mud 0/20"
 DST 3824-70 open 1 hr. 600' GIP
 Rec. 185' msw 390/20" TD 3900

D & A