


Section 28 Township 10 Range 23W

Well No. #3 Wickizer "BW"

Company Wickizer.

NORTH

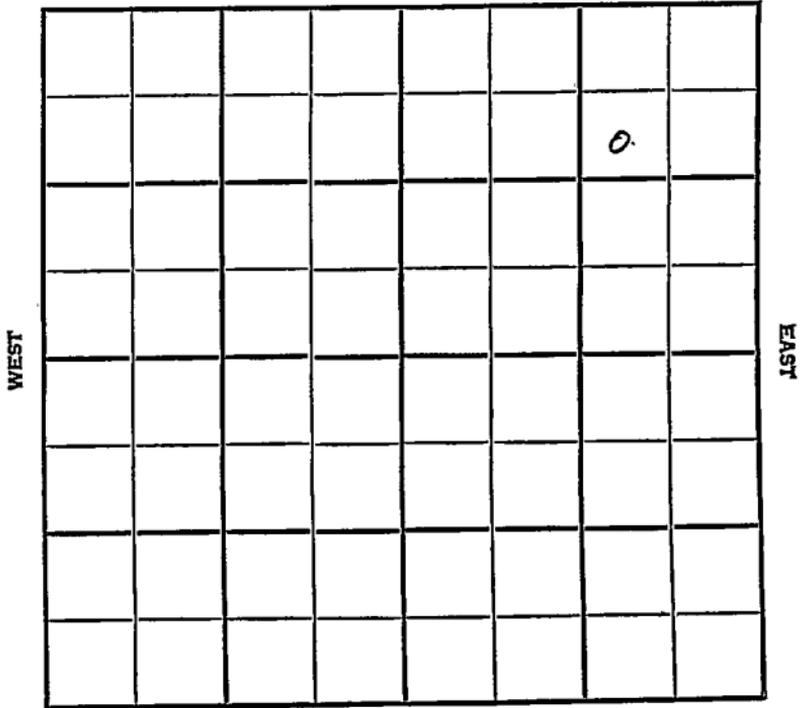

SOUTH





