


DX 78-1 Graham

KANSAS

Section 28 Township 10 Range 23W

Well No. #5 Fee / Wickizer "B"

Company Wickizer Hull-Wickizer

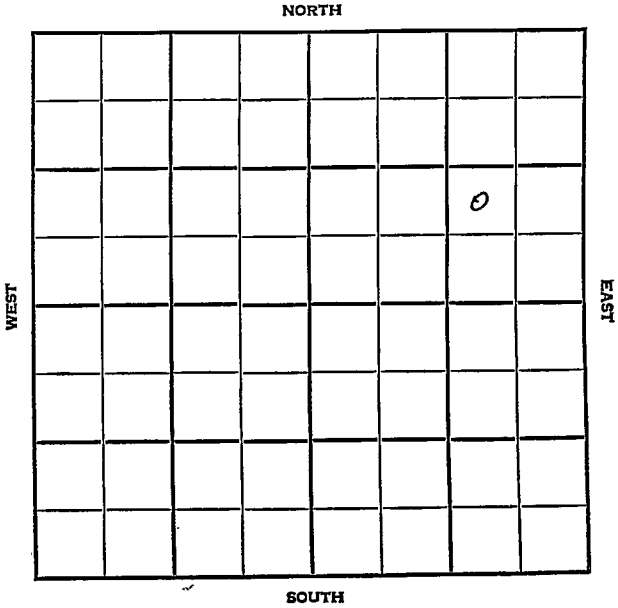

Graham KANSAS

SEC.	TWP.	R.
28	10	23W
WELL NO. #1 Wickizer "B"		
~~5 Fee~~		
COMPANY		FARM
Hull-Wickizer		
~~Wickizer~~		
CONTRACTOR		
Co. Tools.		


SE Happy Pool

_____ Ft. from N. Line

990 _____ Ft. from S. Line

990 _____ Ft. from E. Line

_____ Ft. from W. Line

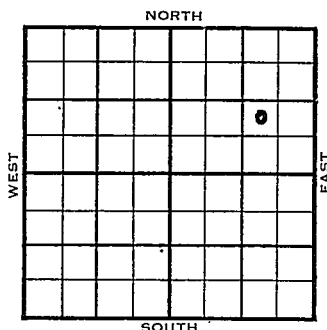

NW SE NE

	ELEVATION	REPORT
1954	2375'	

11/3 Location

1955

3/2 Spud 1-3-55
Oil Well
TD 3890'
8" @ 360'
Anhy 1895' Top 3372' Heeb 3597'
Lans 3634'
DST 3625'-65' opn 1 hr, rec 425' wcm
& msw 1120#
DST 3790'-3818' opn 1 hr 20 min, rec
70' gas, 110' o & gcm
DST 3820'-37' opn 1 hr, rec 360' gas
150' ho & gcm 400 #
DST 3840'-50' opn 1 hr 15 min, rec
2070' gas, 810' oil & mco, 980#
B KC 3868'
TD 3890'
5" @ 3888'
CO 20/ 3844-49 P/ 2 tanks 24 hr.
Comp BHB 451 bopd.

COMPLETED

County Graham State Kansas

Sec. 28 (Blk. Twp.), 10 (Sur. Rge.) 23W Map No.

Operator **Wickizer**

Well No. **5** Farm **Fee**

Elev.	2375	Location	NW SE NE
-------	------	----------	----------

FIRST REPORT

990 Ft. From S Line NE

990 Ft. From F. Line Quarter

1st. Report NOV 3 1954

Completion

Remarks

Spudding Date

Drig. Data SE Happy Pool

Location

FAMILY GILSTRAP

SCOUT TICKET DX-201

Kansas

SEC.	TWP.	R.
28	10	23W

WELL NO.

1 Wickizer "B"

FARM

COMPANY

Hull-Wickizer

CONTRACTOR

CORRECTION

NW SE NE

____ FT. FROM N. LINE

990 FT. FROM S. LINE

990 FT. FORM E. LINE

____ FT. FROM W. LINE

NORTH

WEST

EAST

SOUTH

Graham County

☐ LOCATION

☐ RIG UP

DRILLING AND REMARKS:

Reported

Wickizer

#5 Fee

RECORD

CASED IN., FT.

SAND

GAS

OIL

TOTAL DEPTH

PRODUCTION

1ST 24 HRS. NAT.

1ST 24 HRS. AFTER SHOT

GAS CU. FT.

DRY HOLE

ABANDONED


DATE

JAN 26 1955

SCOUT

FABEN GILSTRAP

County Graham State Kansas
 Sec. 28 (Blk.) 10 (Sur.) 23W Map No.
 Operator Hull-Wickizer
 Well No. 1 Farm Wickizer "B"
 Elev. 2375 Location NW SE NE

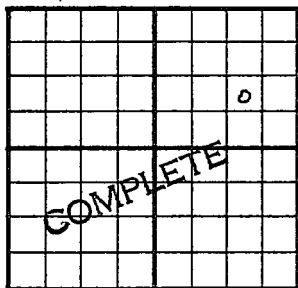

990 Ft. From S Line NE
990 Ft. From E Line Quarter
 1st. Report
 Completion MAR 2 1955
 Remarks SE Happy Pool
Co. tools
 Spudding Date 1-3-55

Drlg. Data Oil well TD 3890
8" @ 360 Anhy 1895 Top. 3372
Heeb. 3597 Lans. 3634 DST 3625-65
open 1 hr. Rec. 425' wcm & msw 1120#
DST 3790-3818 open 1 hr. 20 min. Rec.
70' gas 110' o & gom DST 3820-37
open 1 hr. Rec. 360' gas 150' ho & gom
400# DST 3840-50 open 1 hr. 15 min.
Rec. 2070' gas 810' oil & mco 980#
B KC 3868 TD 3890 5" @ 3888 CO
20/ 3844-49 P/ 2 tanks 24 hr.
Comp. BHB 451 bopd

FABEN GILSTRAP