


Map No. **KANSAS** Sec. **28** Twp. **10** R. **2W**
 Well No. **1- Ottawa Co. Bank** Farm
Anderson et al Company

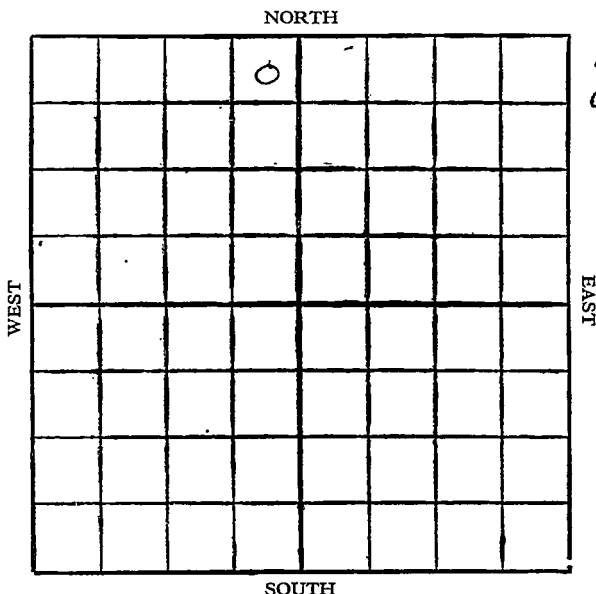

Location

Drilling Remarks

Rig Up

Drilling Remarks

13²²

RECORD

Cased in. ft.

Sand

Gas

Oil

Total Depth

PRODUCTION

1st 24 hrs. Nat.

1st 24 hrs. after shot

Gas cu. ft.

Dry Hole

Abandoned

Map No. **KANSAS** Sec. 28 Twp. 10 R. 2WWell No. 1- Ottawa Co. Bank
Anderson et al Company


NORTH

330 Ft. from N. Line

Ft. from S. Line

330 Ft. from E. Line

Ft. from W. Line

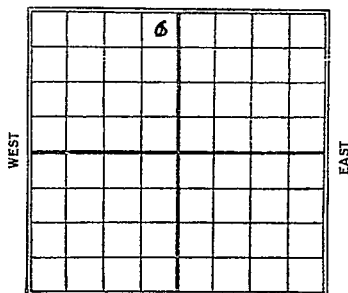

SOUTH

1928

Date

REPORT

5/31	Rig
6/6	Rig up
6/13	Drlg 300
6/20	" 810
6/27	" 1525
7/3	" 1705
7/11	" 2050'
7/18	" 2140
7/15	Run'g 8" - 2140
8/1	Drlg 2350
8/7	T.D. 2350 - S.D.
8/15	—
8/22	—
9/5	—
9/13	—
9/19	—
9/26	T.D. 2375' VIR-10"
10/3	Drlg 2512'
10/10	T.D. 2512' - Rig pulled in
10/17	—
10/24	drlg 2710'
10/31	Run'g 8" - 2750'

11/7- Drly 2790'
11/14- " 2810'
11/21- S.D. 2810 T.D.
11/28- Top chat 2906'
S.D. - 2915' - T.D.

12/5 _____

12/12 _____

12/19 _____

12/26 _____

1929

1/2 _____

1/9 _____

1/16 _____

1/23 _____

1/30 _____

2/6 _____

2/13 _____

2/20- drly 3140'

2/27- T.D. 3140- Rig burned

3/6- Bldg Rig

3/13

3/20- Rign up

3/27- Drly 3185'

4/3- " 3275'

4/10- " 3370'

4/17- T.D. 3618- S.D.

4/24 _____

5/1 _____

5/8 _____

5/14 _____

5/22- S.D. 3655'

5/29- Cem. Curve 3670

6/5 _____

6/12- Run 5"-3690

6/19- C.O. 3690

6/26- T.D. 3755'

Wny & Abandoned

Map No. *KANSAS* Sec. *28* Twp. *10* R. *2W*Well No. *1 Ottawa County Bank**Anderson et al* Company

Contractor

SECTION PLAT

330 Ft. from N. Line

Ft. from S. Line

330 Ft. from E. Line

Ft. from W. Line

	0		

FIRST REPORTS

Location

Rig up

Drilling and Remarks:

RECORD

Cased _____ in., _____ ft.

Sand _____

Gas _____

Oil _____

Total Depth _____

PRODUCTION

1st 24 hrs. Nat. _____

1st 24 hrs. after shot _____

Gas _____ Cu. Ft.

Dry Hole _____

Abandoned _____

Date

MAY-31-1928

S. J. LEWIS

Scout

Ottawa

Contractor

SECTION PLAT

330 Ft. from N. Line
 _____ Ft. from S. Line
330 Ft. from E. Line
 _____ Ft. from W. Line

ABANDONED

Location _____

Rig up _____

Drilling and Remarks:

L & A

RECORD

Cased _____ in., _____ ft.

Sand _____

Gas _____

Oil _____

Total Depth 3755

PRODUCTION

1st 24 hrs. Nat. _____

1st 24 hrs. after shot _____

Gas _____ Cu. Ft.

Dry Hole _____

Abandoned _____

Date

JUN 26 1929

S. J. LEWIS

Scout