

KANSAS Rocks


Section 28 Township 10 Range 19W

Well No. 1 Miller

Company Nadel & Gussman

Wildcat

NORTH

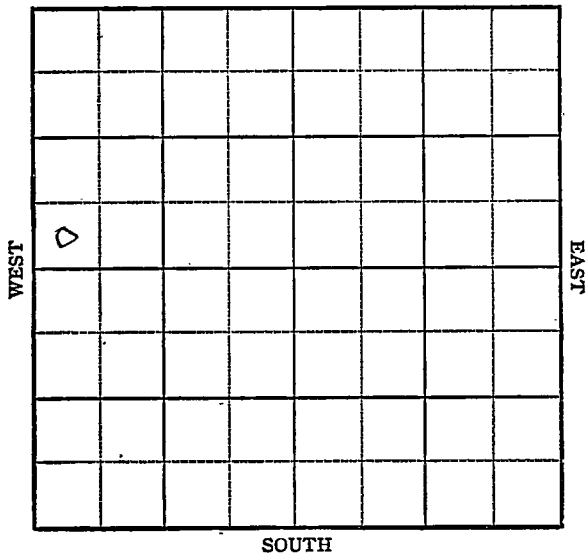

KANSAS

Rooks



Sec. 28 Twp. 10 R. 19E

Well No. #1 Miller Farm

Nadel & Gussman Company

Wildcat


_____ Ft. from N. Line

330' _____ Ft. from S. Line

_____ Ft. from E. Line

330' _____ Ft. from W. Line

SW NW

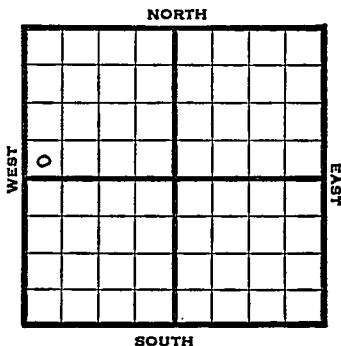

1948

Eli 2196'

REPORT

8/18 Surface Hole

8/25 8" @ 160'

Drlg 2664'

9/1 Lansing 3444'

Cong 3698'

Arb. 3781'

TD 3811'

Aband.

ABANDONED

Rooks County Kansas State

Map No. _____ Sec. 28 Twp. 10 R. 19W

Well No. 1 Miller

Nadel & Gussman Company

FIRST REPORT Contractor

SW NW

SECTION PLAT

_____ Ft. from N. Line

330 Ft. from S. Line

350 Ft. from E. Line

320 Ft. from W. Line

Wildcat

Remarks:

surface hole

Date
AUG 1 8 1948

Scout
S. J. LEWIS

Rooks County Kansas State

Map No. 65 Sec. 28 Twp. 10 R. 19W

Well No. 1 Miller

Nadel & Gussman Company

ABANDONED

Contractor

E1.2196

SECTION PLAT

SW NW

Ft. from N. Line

330 Ft. from S. Line

Ft. from E. Line

330 Ft. from W. Line

Wildcat

Remarks:

Lane 3444

Long 3698

Art 3781

YD 3811

Date SEP 1 1948

Scout S. J. LEWIS