


Section 28 Township 10 Range 20W

Well No. #1 Tribble

Company Sterling Drlg. et al

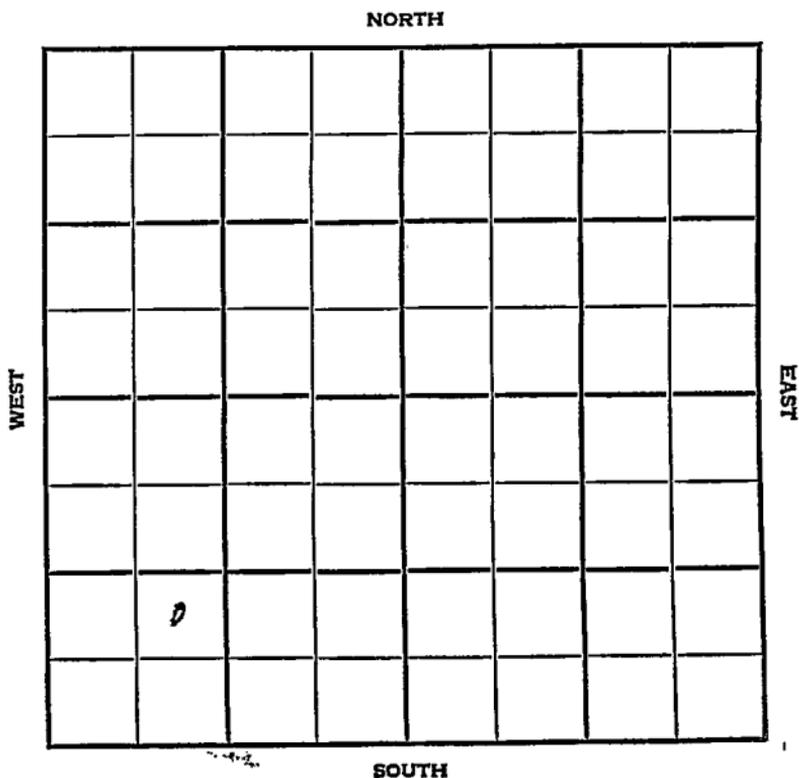

Rooks KANSAS

SEC.	TWP.	R.
28	10	20 W

WELL NO. # 1 Tribble FARM

COMPANY Sterling Drlg. et al

CONTRACTOR Sterling Drlg.

Allphin Pool


\_\_\_\_\_ Ft. from N. Line

990 \_\_\_\_\_ Ft. from S. Line

\_\_\_\_\_ Ft. from E. Line

990 \_\_\_\_\_ Ft. from W. Line

NE SW SW

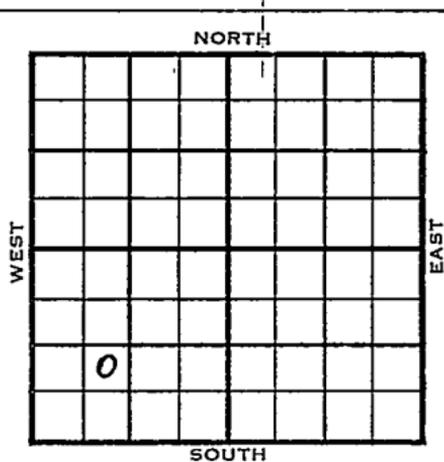

1954	ELEVATION 2162'	REPORT
------	--------------------	--------

12/22  
1955  
2/9

MIR

Spud 12-23-54

Oil Well

TD 3759'

8" @ 200'

Heeb 3415' Lans 3454' Chert. 3705'

Arb. 3748'

DST 3750'-59' opn 1 hr, rec 34' hocm

30' socm 880#

TD 3759'

5" @ 3750

CO to 3759'

S/ 1 boph 500 A S/ 2 1/2 boph 4 hr.

Comp 55 bopd.

**COMPLETED**

County Rooks State Kansas

Sec. 28 (Blk. 10 (Sur. Rge.) 20W Map No.

Operator Sterling Drlg. etal.

Well No. 1 Farm Tribble

Elev. \_\_\_\_\_ Location NE SW SW


990 Ft. From S Line SW

990 Ft. From W Line Quarter

Ist. Report DEC 22 1954

Completion

Remarks

Sterling Drlg. - Contr.

Spudding Date

Drlg. Data Allphin Pool

M I R

