


SECTION 28 TOWNSHIP 10S RANGE 20W

WELL NO. #5 Tribble

COMPANY Sterling Drlg.

NORTH W/2 NE SW

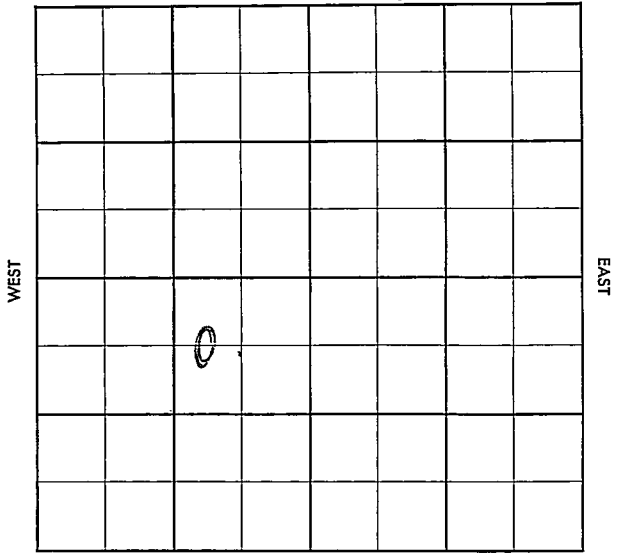

SOUTH



County Rooks Elev. 2161 RB  
 Sec. 28 Twp. 10 Rge. 20W  
 Company Sterling Drlg.  
 FarmName Trible No. 5

TOPS	DEPTH	LOG	DATUM
Anh.			
Tp.	X 2239		
H.	3412		
Tr.			
Dg.			
Bl.			
L.	3452		
K.C.			
B.K.C.			
Ce.			
C.	3711		
M.			
M.			
K.			
Mz.			
Me.			
V.			
S.			
S.			
A.			
R.			
PE.			
G.			
TD.	3790		

Loc. in Sec. W/2 NE SW  
 Geol. \_\_\_\_\_  
 Contr. CO Tools 6<sup>th</sup>  
 Pool Trico  
 ABANDONED  
 SEP 11 57

Date Comm. \_\_\_\_\_  
 Drlg. 2100: SEP 11 57 X 5 puds 8-31-57  
 8<sup>5</sup> 200/135 TOPS NOT STS NO  
 Log D to A

Rig to first report