


Section 28 Township 10 Range 20W

Well No. 3 Treble

Company Sterling Drlg.

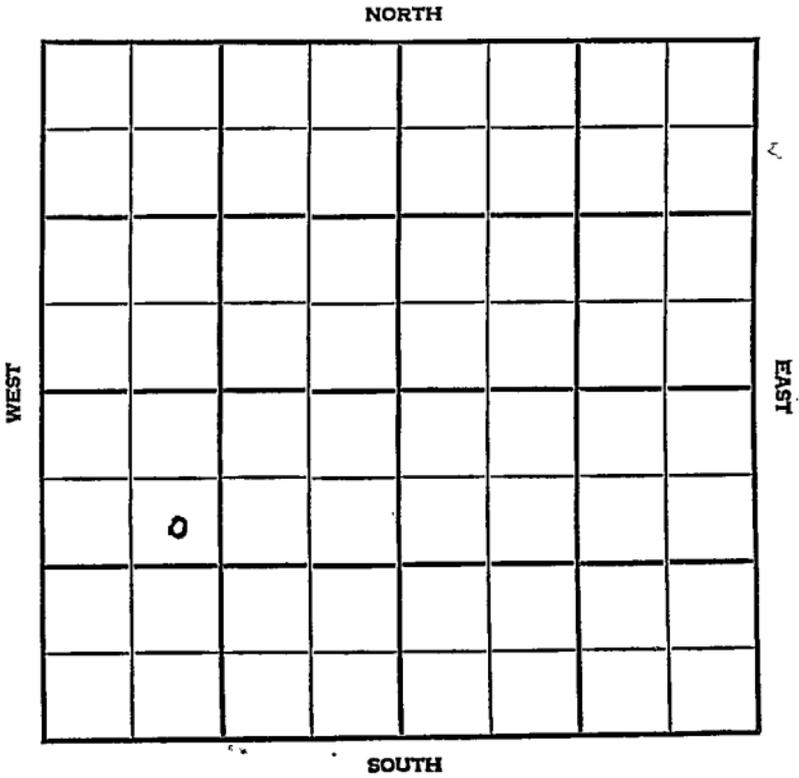

Rooks

KANSAS

SEC.	TWP.	R.
28	10	20 W

WELL NO. # 3 Treble FARM

COMPANY

CONTRACTOR Sterling Drlg.


Co. tools
Allphin Pool

990 Ft. from N. Line

Ft. from S. Line

Ft. from E. Line

990 Ft. from W. Line

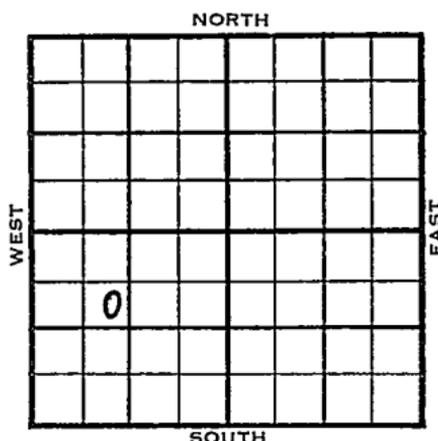

SE NW SW

ELEVATION

REPORT

1955

3/9

Spud 3-5-55
8" @ 200
Anhy 1655'
Drlg. 2310'

