

Rooks KANSAS

SEC.	TWP.	R.
28	10	20W

WELL NO. _____
 COMPANY I Thomas FARM

CONTRACTOR I. O. Miller


Virginia Drlg.
 Allphin Pool

_____ Ft. from N. Line

330 _____ Ft. from S. Line

_____ Ft. from E. Line

330 _____ Ft. from W. Line

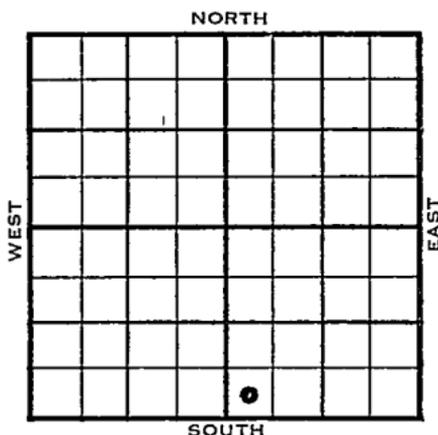

SW SW SE

1955	ELEVATION 2144'	REPORT
------	--------------------	--------

3/16

MIR

3/30

Spud 3-15-55

D & A

TD 3770'

8" @ 242'

Top 3190' Heeb. 3401' Tor. 3420'

Lans 3438'

DST 3595'-3660' opn 1hr 50 min, rec 50'

Mud, O#

B KC 3670' Cong. 3687' Arb. 3751'

DST 3754'-60' opn 1 hr, rec 60' Mud

O#

TD 3770'

D& A

ABANDONED

