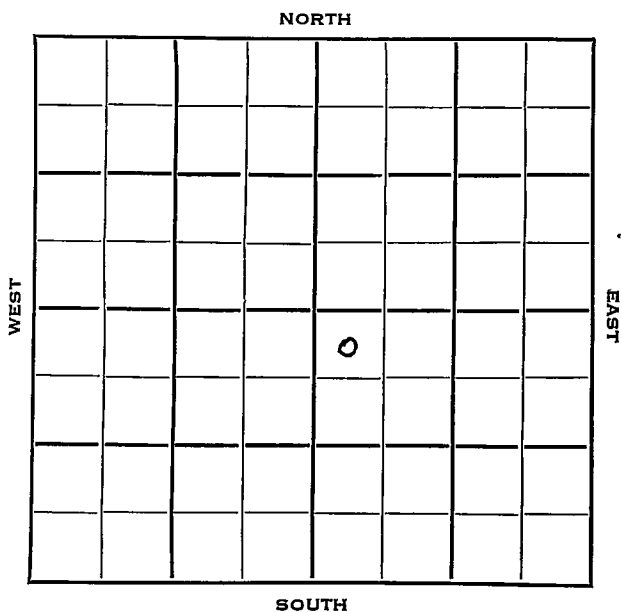


Section 28 Township 10 Range 20WWell No. 1 ThomasCompany Derby & Champlin

Rooks

KANSAS

SEC.

TWP.

R.

28

10.

20W

WELL NO.

#1 Thomas

FARM

COMPANY

Derby & Champlin

CONTRACTOR

Wildcat

330

Ft. from N. Line

Ft. from S. Line

Ft. from E. Line


330

Ft. from W. Line

NW NW SE

Deep Rock F/O

NORTH

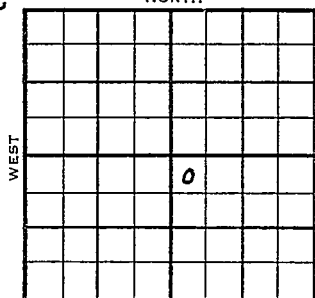

SOUTH

1953

ELEVATION

2171'

REPORT

9/16

Location

9/23

RUR

9/30

8" @ 160'

Drlg 3408'

10/7

Spud 9-22-53 D & A TD 3860

8" @ 160 Heeb 3431 Lans 3470

Cong. 3722 Simp 3783 Arb. 3813

TD 3860' D & A

ABANDONED

County Rooks State Kansas
 Sec. 28 (Blk. 10 (Sur. 20W Map No. 10)
 Operator Derby & Champlin
 Well No. 1 Farm Thomas
 Elev. Location NW NW SE

FIRST REPORT

330 Ft. From N Line SE
330 Ft. From W Line Quarter
 Ist. Report SEP 1 4 1953
 Completion
 Remarks Deep Rock farmout
 Spudding Date

Drlg. Data Wildcat
 Location

J. G. McGEHEE

J. G. McGEHEE