


Section 28 Township 10 Range 20W

Well No. #4 Tribble

Company Sterling Drlg.

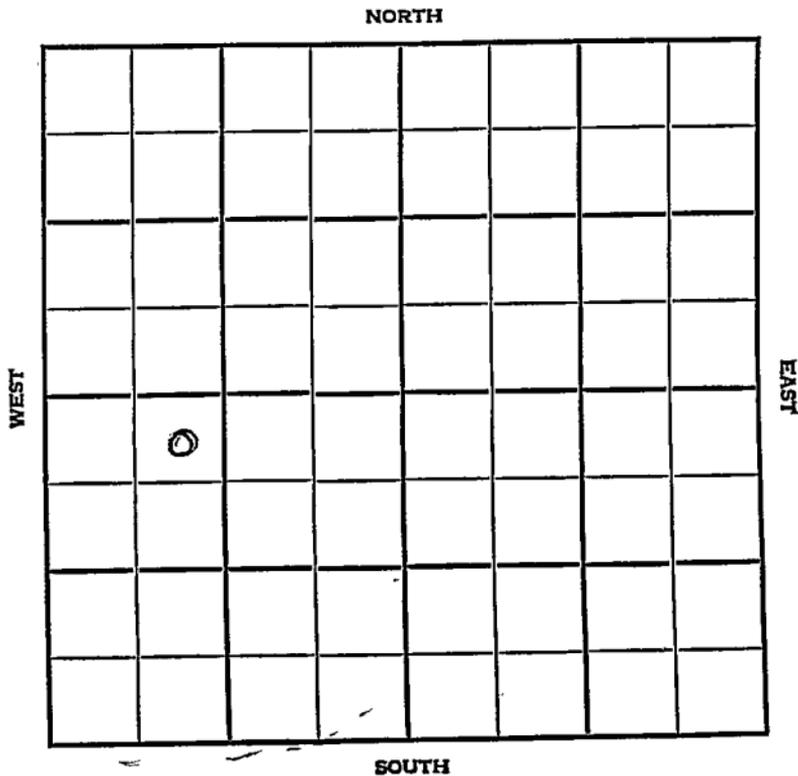

County Rooks State Kansas

Sec. 28 (Blk. 10 (Sur. Rge.) 20W Map No.

Operator Sterling Drlg.

Well No. 4 Farm Trible

Elev. _____ Location NE NW SW

330 Ft. From N Line SW

990 Ft. From W Line Quarter

Ist. Report JUN 1 1955

Completion _____

Remarks _____

Co. tools

Spudding Date 4-27-55

Drlg. Data Allphin Pool

8" @ 200 w/ 125 drlg. 2700

FIRST REPORT

County Rooks Elev. 2171
 Sec. 28 Twp. 10N Rgs. 20W
 Company Sterling Drlg.
 FarmName Trible No. 4

TOPS	DEPTH	LOG	DATUM	Loc. in Sec.																												
Anh.				NE NW SW																												
Tr.																																
H.	<u>3409</u>																															
Tr.	<u>3429</u>																															
Dg.																																
Bl.																																
L.	<u>3449</u>			Geol.																												
K.C.				Contr.																												
B.K.C.				Co. tools																												
Ce.				Pool																												
C.	<u>3698</u>			Allphin																												
M.				<table border="1"> <tr><td></td><td></td><td></td><td></td></tr> <tr><td></td><td></td><td></td><td></td></tr> <tr><td></td><td></td><td></td><td></td></tr> <tr><td></td><td></td><td></td><td></td></tr> <tr><td></td><td></td><td></td><td></td></tr> <tr><td></td><td></td><td></td><td></td></tr> <tr><td></td><td></td><td></td><td></td></tr> </table>																												
M.																																
K.																																
Mz.																																
Me.																																
V.																																
S.	<u>3710</u>		<u>1539</u>																													
S.																																
A.	<u>3732</u>		<u>1561</u>																													
R.																																
PE.																																
G.	<u>52</u>		<u>1563</u>																													
T.D.	<u>3737</u>		<u>1566</u>																													

Date Comm. 4-27-55 JUL 6 1955

8" @ 200/125 5 $\frac{1}{2}$ " @ 3734 CO to 3737

FU 1130' oil 30 min. DD 3741

FU 2500' oil 3 hr. S/ 55 boph 3 hr.

500 A S/ 110 bo 1 $\frac{1}{2}$ hr. S/ 39 bo

30 min. Comp. 3000 bopd

COMPLETE