


Section 28 Township 10 Range 20W

Well No. 1 <sup>+</sup>Towns<sub>5</sub>

Company I. O. Miller

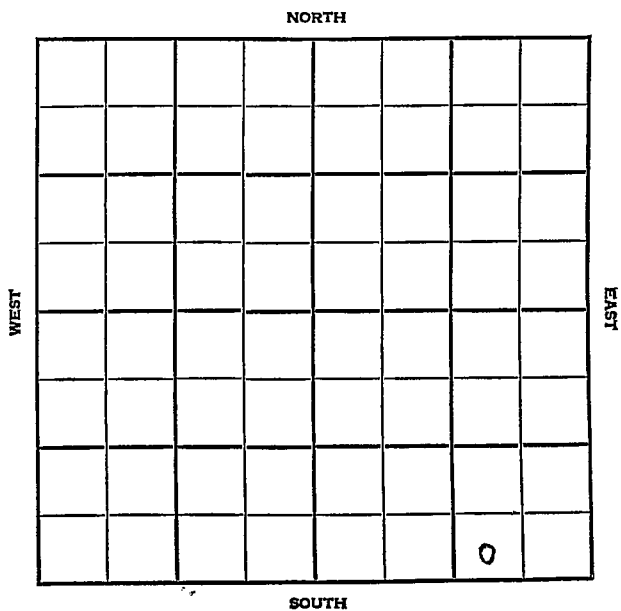

Rooks

KANSAS

SEC.	TWP.	R.
28	10	20 W

WELL NO. # 1 Towns FARM

COMPANY I. O. Miller

CONTRACTOR Virginian Drlg.


Allphin Ext.

\_\_\_\_\_ Ft. from N. Line

330 \_\_\_\_\_ Ft. from S. Line

990 \_\_\_\_\_ Ft. from E. Line

\_\_\_\_\_ Ft. from W. Line

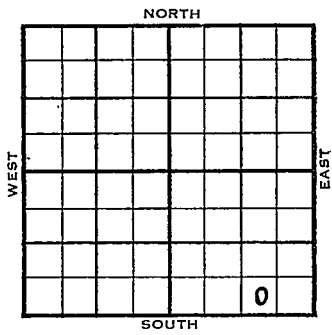

SW SE SE

1955	ELEVATION	REPORT
	2162'	

3/2

Spud 2-26-55  
8" @ 245 WOC

3/16

Spud 2-26-55 -D&A TD 3775  
8" @ 245 Anhy 1638, Heeb 3423,  
Tor. 3449, Lans 3461, B KC 3679,  
Cong. 3714, TD 3775  
D&A

ABANDONED



