


Section 28 Township 10 Range 20W

Well No. #1 Williams

Company Virginia Drlg.

NORTH

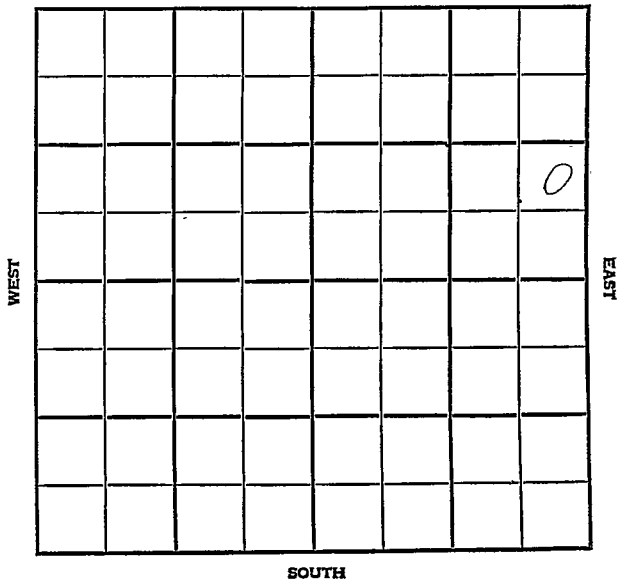

County Rooks Elev. 2171
 Sec. 28 Twp. 70 Rgs. 20W
 Company Virginia Drlg.
 Farm Name Williams No. 1

TOPS	DEPTH	LOG	DATUM	Loc. in Sec.
Anh.				NE SE NE
Tp.				
H.				
Tr.				
Dg.				
BL.				
L.	3552			Geol.
K.C.				Contr.
B.K.C.	3700			Co. tools
Ce.				Pool
C.				Annon Ext.
M.				<div style="border: 1px solid black; padding: 5px; text-align: center;"> ABANDONED DEC 5 '56 </div>
M.				
K.				
Mz.				
Mo.				
V.				
S.				
S.				
A.				
R.				
PE.				
G.				
T.D.	3781			

Date Comm. NOV 21 '56 ✓ NO. 2nd Ed 71-23-56

878 234/125 2960 DEC 5 '56

D.E.A.

Col. No. Sec. T. R.