


DX 78-1

Rooks

Section 28 Township 10 Range 20^W

Well No. 2 Williams

Company Kaiser & Francis O & G

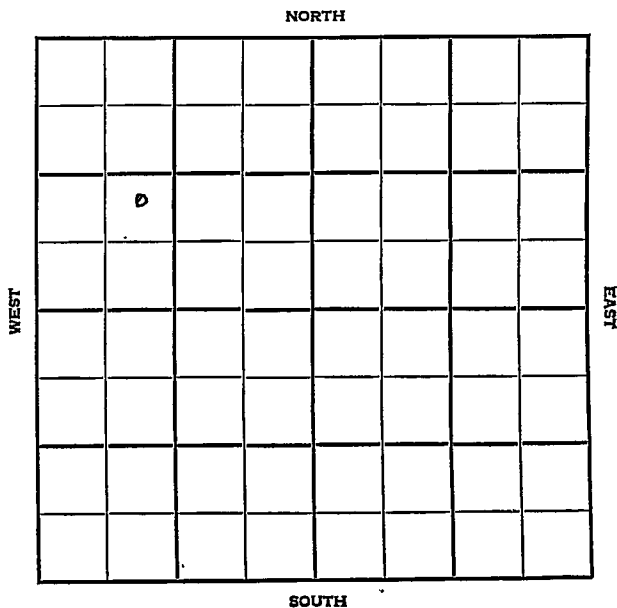

Rooks

KANSAS

SEC.	TWP.	R.
28	10	20W

WELL NO. 2 Williams FARM

COMPANY Kaiser & Francis O & G

CONTRACTOR K & E Drlg

Allphin

_____ Ft. from N. Line	<table border="1"> <tr><td></td><td></td><td></td><td></td><td></td><td></td><td></td><td></td></tr> <tr><td></td><td>0</td><td></td><td></td><td></td><td></td><td></td><td></td></tr> <tr><td></td><td></td><td></td><td></td><td></td><td></td><td></td><td></td></tr> <tr><td></td><td></td><td></td><td></td><td></td><td></td><td></td><td></td></tr> <tr><td></td><td></td><td></td><td></td><td></td><td></td><td></td><td></td></tr> <tr><td></td><td></td><td></td><td></td><td></td><td></td><td></td><td></td></tr> <tr><td></td><td></td><td></td><td></td><td></td><td></td><td></td><td></td></tr> <tr><td></td><td></td><td></td><td></td><td></td><td></td><td></td><td></td></tr> </table>										0	
		0	
_____ Ft. from S. Line	
_____ Ft. from E. Line	
_____ Ft. from W. Line	

NE SW NW

1955	ELEVATION	REPORT
	2181'	

6/22 Location

8/10 Comm 6-23-55

H	3426
Tr	3444
L	3464
C	3715
S	3734
A	3752
TD	3758

8 5/8" 205 w/140; DST 3753-58 op 1 hr
 rec 180' oil, BHP 950# 15"; 5 1/2"
 3753; CO DD 3759; swb 4.64 boph no
 wtr. 2 hrs; swb 32 boph no wtr 4 hrs
 POP
 Phy pmp 481 bopd no wtr.

COMPLETED

County Rooks Elev. _____
 Sec. 28 Twp. 10 Rgs. 20W
 Company Kaiser & Francis O & G
 Farm Name Williams No. 2

TOPS	DEPTH	LOG	DATUM
Anh.			
Tp.			
H.			
Jr.			
Dg.			
Bl.			
L.			
K.C.			
B.K.C.			
Ce.			
C.			
M.			
M.			
K.			
Mz.			
Me.			
V.			
S.			
S.			
A.			
R.			
Pe.			
G.			
T.P.			

Loc. in Sec. _____

NE SW NW

Geol. _____

Contr. _____

K & E Drlg.

Pool _____

Allphin

0
 JUN 22 1955
 FIRST REPORT

Date Comm. _____

Location _____

Co.

Lse.

No.

Sec.

T.

R.

County Rooks Elev. 2181
 Sec. 28 Twp. 10S Rge. 20W
 Company Kaiser & Francis Oil & Gas
 Farm Name Williams No. 2

TOPS	DEPTH	LOG	DATUM
Anh.			
T.P.			
H.	<u>3426</u>		<u>1245</u>
Tr.	<u>3444</u>		<u>1263</u>
Dg.			
Bl.			
L.	<u>3464</u>		<u>1283</u>
K.C.			
B.K.C.			
Ce.			
C.	<u>3715</u>		<u>1534</u>
M.			
M.			
K.			
Mz.			
Me.			
V.			
S.	<u>3734</u>		<u>1553</u>
S.			
A	<u>3752</u>		<u>1571</u>
R.			
PC.			
G.			
T.D.	<u>3758</u>		

Loc. in Sec. NE SW NW
 Geol. _____
 Contr. _____
K & E Drlg.
 Pool Allphin

COMPLETE
 AUG 10 1955

Date Comm. 6-23-55; 8-5/8" 205 w/140; DST 3753-58
op 1 hr. rec. 180' oil, BHP 950# 15";
5 1/2" 3753; CO DD 3759; swb 4.64 boph no wtr.
@ hrs.; swb 32 boph no wtr. 4 hrs.; POP
Phy. pmp 481 bopd no wtr.