


Section 29 Township 10 Range 23 W

Well No. #1 Mildred P/ott

Company Stanolind

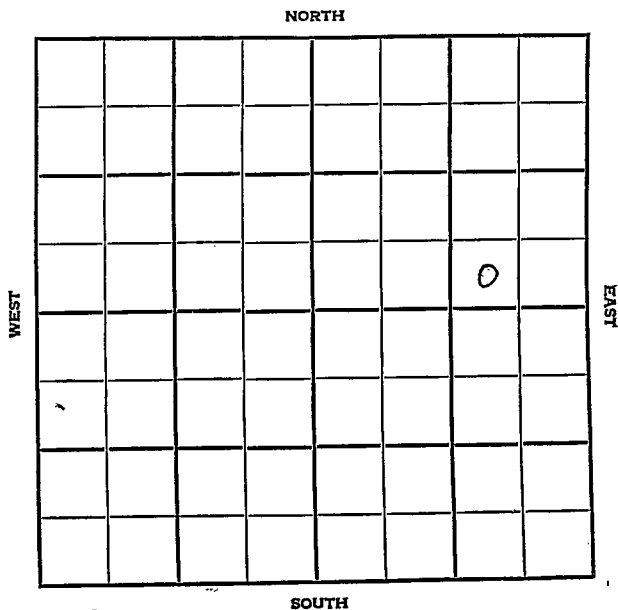

Graham

KANSAS

SEC.	TWP.	R..
29	10	23W

WELL NO. #4 Mildred P/Ott FARM

COMPANY Stanolind

CONTRACTOR Barbour


Diebolt

_____ Ft. from N. Line

_____ Ft. from S. Line

_____ Ft. from E. Line

_____ Ft. from W. Line

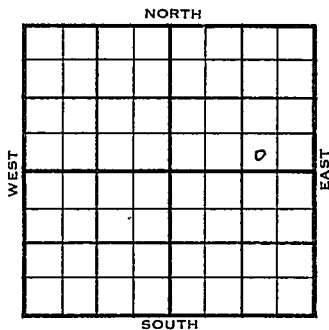

SW SE NE

1955	ELEVATION 2388'	REPORT
------	--------------------	--------

10/12 Comm 10-9-55
8" @ 210/150
Drlg 211

11-23 5 1/2" @ 3939/800
CO to 3906, 16/ 3820-24
S/ 5 boph 3 hrs. 1000 A
S/ 13 boph 9 hr.
Comp. 139 bopd
Anh. 1900
H. 3617-3626
L. 3652-3662
B.K.C. 3890
TD 3940'

COMPLETED

County Graham Elev. _____
 Sec. 29 Twp. 10 Rge. 2 3W
 Company Stanolind
 Farm Name Mildred P/ Ott No. 4

Co.

TOPS DEPTH LOG DATUM

Anh.			
Tp.			
H.			
Tr.			
Dg.			
Bl.			
L.			
K.C.			
B.K.C.			
Ce.			
C.			
M.			
M.			
K.			
Mz.			
Me.			
V.			
S.			
S.			
A			
R.			
PE.			
G.			
T.D.			

Loc. in Sec. SWSE NE

Geol. _____
 Contr. Barbour

Pool Mebolia

FIRST REPORT
 OCT 12 '55

Lse.

Date Comm. 10-9-55
8" @ 210/150 drlg. 211

No.

Sec.

T.

R.

[Handwritten signature]

County Graham Elev. 2388
 Sec. 29 Twp. 10 Rge. 23W
 Company Stanolind
 Farm Name Mildred P. Ott No. 4

Co.

TOPS	DEPTH	LOG	DATUM
Anh.	1900		
TP.			
H.	3617	3626	1238
Tr.			
Dg.			
BL.			
L.	3652	3662	1274
K.C.			
B.K.C.		3890	1502
Ce.			
C.			
M.			
M.			
K.			
Mz.			
Mo.			
V.			
S.			
S.			
A.			
R.			
PE.			
G.			
TD.	3940		

Loc. in Sec. SW SE NE

Geol. _____
 Contr. _____
 Barbour
 Pool **HAPPY**
 Diebolt

Lse.

COMPLETE		

No.

Date Comm. 10-9-55 NOV 23 1955
8" @ 210/150. 5 $\frac{1}{2}$ " @ 3939/800 GO to 3906

Sec.

16/ 3820-2h S/ 5 boph 3 hr. 1000 A
S/ 13 boph 9 hr. Comp. 139 bopd

T.

R.