


Section 29 Township 10 Range 23W

Well No. #1 Mildred P. Ott.

Company Stanolind.

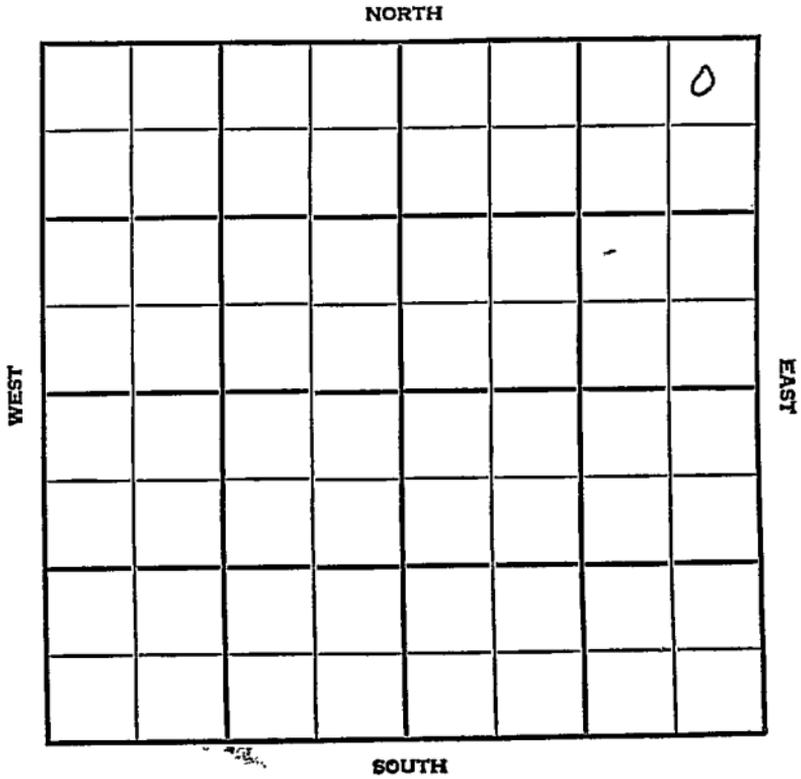

Graham KANSAS

| | | |
|------|------|-----|
| SEC. | TWP. | R. |
| 29 | 10 | 23W |

WELL NO. 1 Mildred P. Ott FARM
 COMPANY

CONTRACTOR Stanolind

Barbour
 Happy Pool


330 Ft. from N. Line

Ft. from S. Line

330 Ft. from E. Line

Ft. from W. Line

NE NE NE

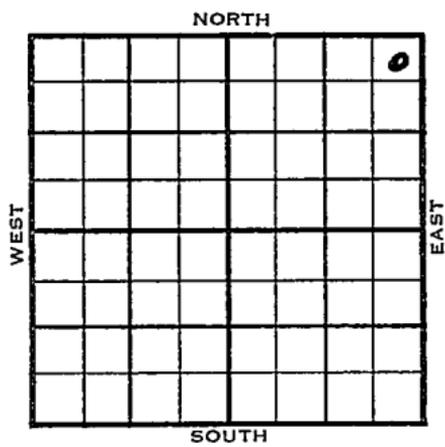

| | | |
|------|--------------------|--------|
| 1955 | ELEVATION 2401' | REPORT |
|------|--------------------|--------|

2/23 Location

4/6 Spud 2-25-55, Oil Well, TD 3945
 8" @ 197 Anhy 1950, Heeb 3615
 Lans 3649, TD 3945, 5" @ 3930
 CO to 3895 8/3842-44, 26 GOPH
 32/3834-42, 8/3820-22, 24/3814-
 20 S/13 1/2 BOPH 1000 A S/19
 BOPH 2 hr S/11 BOPH 2 hr,
 Comp. BHB 3000 BOPD

COMPLETED

County Graham State Kansas

Sec. 29 (Blk. 10) (Sur. Rge.) 23W Map No.

Operator Stanolind

Well No. 1 Farm Mildred P. Ott

Elev. 2401 Location NE NE NE

| | | | | | | | | | |
|--|--|--|--|--|--|--|--|--|--|
| | | | | | | | | | |
| | | | | | | | | | |
330 Ft. From N Line NE

330 Ft. From E Line Quarter

Ist. Report

Completion APR 6 1955

Remarks Happy Pool

Barbour - Contr.

Spudding Date 2-25-55

Drlg. Data Oil well TD 3945

8" @ 197 Anhy 1950 Heeb. 3615

Lans. 3649 TD 3945 5" @ 3930

CO to 3895 8/ 3842-44 26 goph

32/ 3834-42 8/ 3820-22 24/ 3814-20

S/ 13 1/2 boph 1000 A S/ 19 boph 2 hr.

S/ 11 boph 2 hr. Comp. BHB 3000 bopd