


Sheridan

KANSAS

SECTION 3 TOWNSHIP 10S RANGE 26W

WELL NO. #1 Deines

COMPANY Leben Drlg.

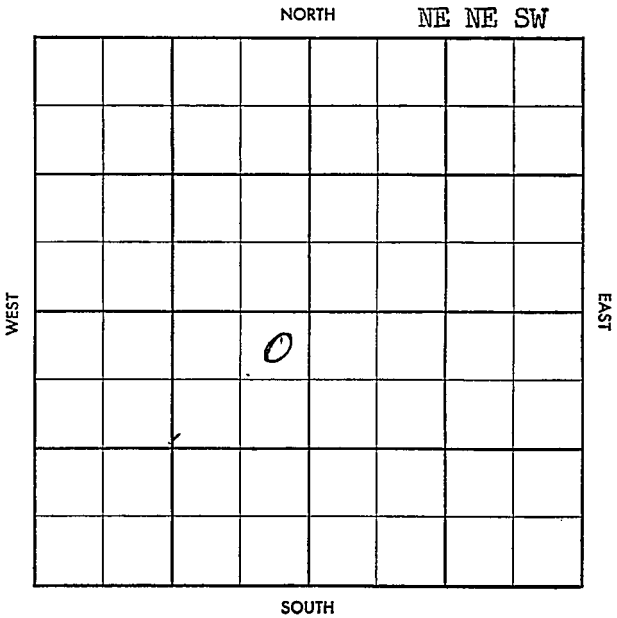

33

WILDCAT

S-513-B

County Shekidan Elev. _____
 Sec. 3 Twp. 10 Rge. 26W
 Company Leben Drilg.
 Farm Name Daines No. 1

TOPS	DEPTH	LOG	DATUM
Anh.			
Tp.			
H.			
Tr.			
Dg.			
B.L.			
L.			
K.C.			
B.K.C.			
Ce.			
C.			
M.			
M.			
K.			
Mz.			
Mq.			
V.			
S.			
S.			
A.			
R.			
Pf.			
G.			
T.D.			

Loc. in Sec. _____
NE NE SW
 Geol. _____
 Contr. _____
Co. tools
 Pool _____
Wildcat

JAN 22 '58
FIRST REPORT

Date Comm. Ted Gore & J. Farmer DHI

Location

Co.
 Lse.
 No.
 Sec.
 T.
 R.

5-513-B

County Sheridan Elev. 25870.5
 Sec. 3 Twp. 10 Rge. 26N 2590RB
 Company Leben Drilg.
 Farm Name Deines No. 1

TOPS	DEPTH	LOG	DATUM
Anh.	2220		
Tp.	3590		
H.	3812		
Tr.	3832		
Dg.			
B.L.			
L.	3850		
K.C.			
B.K.C.	4083		
Ce.			
C.			
M.			
M.			
K.			
Mz.			
Mq.			
V.			
S.			
S.			
A.			
R.			
Pf.			
G.			
T.D.	4103		

Loc. Int. Sec. NE NE SW

Geol. _____
 Contr. Co. tools

Pool Wildcat

ABANDONED
 FEB 12 '58

Date Comm. Ted Gore & J. Farmer DHD

Location W29 3850 1-26-58

8" 236160 #1440 FEB 5 '58 03912

FEB 12 '58 DST 4018-35 60" 12'M

BHPD-150/20 DST 4040-61 90"

65' OCM BHP 1380-220 SP0-0

no log

DBA