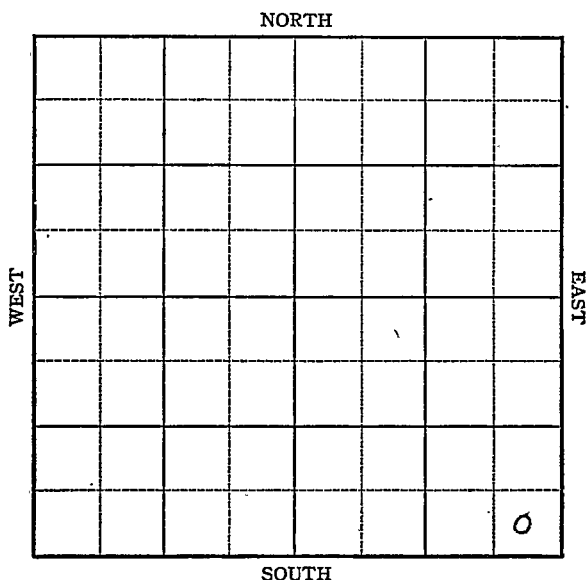


KANSAS

Sheridan county

Section 3 Township 10 Range 27-WWell No. #1, Charles WymanCompany Stanolind Oil and Gas Company

KANSAS Sheridan ✓

Sec. 3 Twp. 10 R. 27W

Well No. #1 Chas. Wyman Farm
" Stanolind Company


Wildcat

_____ Ft. from N. Line

330 Ft. from S. Line

330 Ft. from E. Line

_____ Ft. from W. Line

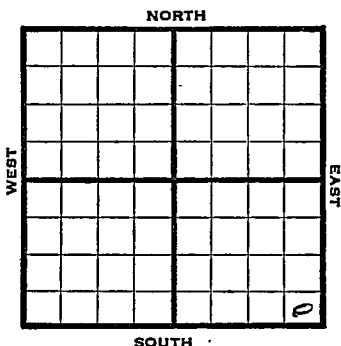

SE/C

1946 Elev. 2623' REPORT

10/23 13" @ 156'

WOC

10/29 Anhy 2205'

Drlg 3150'

11/6 Topeka 3570'

Lans 3805'

Drlg 4080'

11/12 Miss 4413'

Arb 4604

TD 4474 no shows

11/20 Arb 4604'

TD 4674'

ABANDONED

Kansas KANSAS

Map No. 67 Sec. 3 Twp. 10 R. 27WWell No. 1 Chas. Wyman

Stanolind


Company

FIRST REPORT

Contractor

SE/C

SECTION PLAT

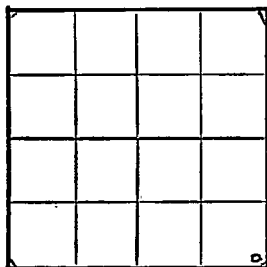 Ft. from N. Line330 Ft. from S. Line330 Ft. from E. Line Ft. from W. Line

Sheridan County

Location Rig up

Drilling and Remarks:

13" @ 156 WOC

RECORD

Cased in., ft.Sand Gas Oil Total Depth

PRODUCTION

1st 24 hrs. Nat. 1st 24 hrs. after shot Gas Cu. Ft.Dry Hole Abandoned

Date

OCT 23 1946

19

S. J. LEWIS

Scout

Map No. 67 Sec. 3 Twp. 10 R. 27W

Well No. 1 Chas. Wyman

Stanolind Company

ABANDONED

Contractor

SE/C


E/2623
SECTION PLAT

 Ft. from N. Line

330 Ft. from S. Line

330 Ft. from E. Line

 Ft. from W. Line

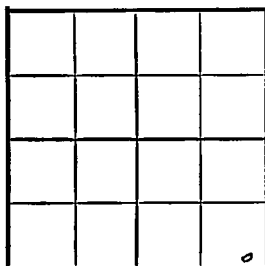

Sheridan County

Location

Rig up

Drilling and Remarks:

Per 4604

RECORD

Cased in., ft.

Sand

Gas

Oil

Total Depth 4624

PRODUCTION

1st 24 hrs. Nat.

1st 24 hrs. after shot

Gas Cu. Ft.

Dry Hole

Abandoned

Date

NOV 20 1946

S. J. LEWIS

Scout