
DX 78-1

Rooks KANSAS

Section 3 Township 10 Range 16 W

Well No. # 1 Welling

Company Transit Corp & Krueger

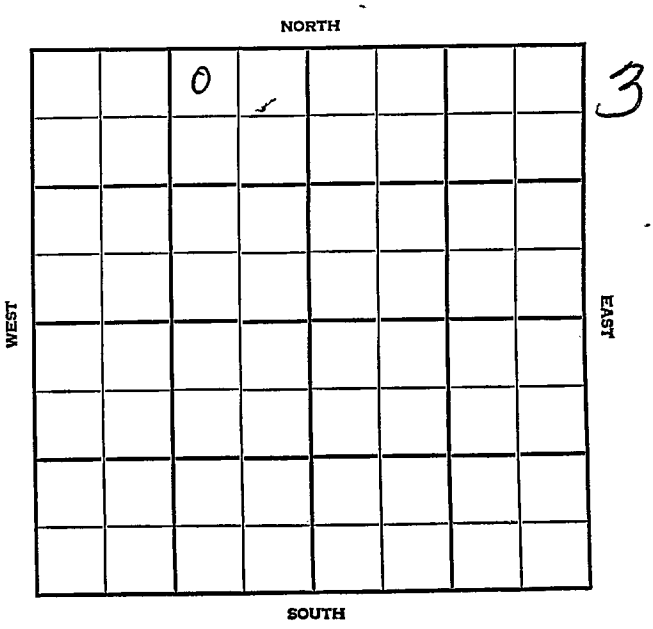

Rooks KANSAS

SEC.	TWP.	R.
3	10	16 W

WELL NO.

1 Welling FARM
COMPANY

Transit Corp & Krueger
CONTRACTOR

Co. tools
Kruse Pool


330 Ft. from N. Line

Ft. from S. Line

990 Ft. from E. Line

Ft. from W. Line

NW NE NW

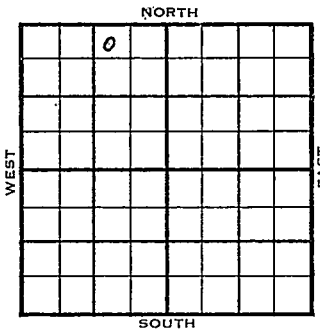

1954	ELEVATION 2065' REPORT
8/11	Spud 8-5-54 8" @ 250 Drlg. 2750'
10/27	Spud 8-5-54 - Oil Well TD 3415' 8" @ 250' Top 2923', Heeb 3155', Tor 3173', Lans 3196' DST 3160-3214', opn 1 hr., rec.150' ocm, 495# DST 3282-93', opn 1 hr., rec. 10' mud, 0# DST 3350-3415', opn 1 hr., rec. 120' muddy sw, 0# TD 3415' 5" @ 3414' CO to 3333' 8/3303-05, 1000A, 34 bfpd 15 bo 19 bw P/4 bo 100 bwpd, reperf/24/3292-96 S/1 boph SP 3270' 36/3253-59, 1000A B/5 go 1 hrs., 24/3231-37, 1000A S/1½ boph, PB 3228', 36/3211-17, 1000A, S/2½ boph, PB 3205', 36/3172-78 250A, ~~24/3198-3202'~~ 24/3198-3202', 1000 S/125' fluid 1 hr., CO to 3270'

DX-78

OVER

(Information Brought Forward)

1954
10/27 S/105' oil 5' wtr, 1 hr.
S/2½ bo 7 gw 14 hrs.,
CO to 3298' FU 140' oil 50' wtr. 1 hr.
Comp. 24 bopd 10% wtr.

COMPLETED

FORM 275 FOR SALE BY KANSAS BLUE PRINT CO.


County Rooks State Kansas

Sec. 3 (Blk. Twp.) 10 (Sur. Rge.) 16W Map No.

Operator Transit Corp. & Krueger

Well No. 1 Farm Welling

Elev. Location NW NE NW

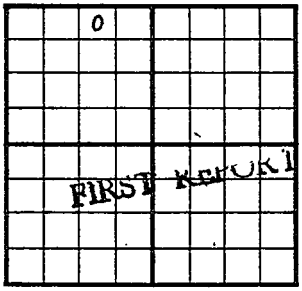

330 Ft. From N Line NW

990 Ft. From E Line Quarter

1st. Report AUG 11 1954

Completion

Remarks -

Co. tools

Spudding Date 8-5-54

Drlg. Data Kruse Pool

8" @ 250 drlg. 2750

72

FORM 275 FOR SALE BY KANSAS BLUE PRINT CO.


County Rooks State Kansas

Sec. 3 (Blk. / Twp.) 10 (Sur. / Rge.) 16W Map No.

Operator Transit Corp. & Krueger

Well No. 1 Farm Welling

Elev. 2065 Location NW NE NW

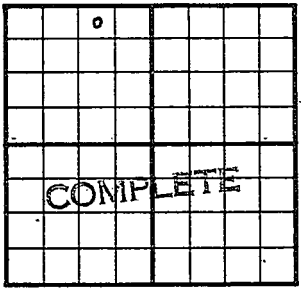

330 Ft. From N Line NW

990 Ft. From E Line Quarter

1st. Report

Completion OCT 27 1954

Remarks Krause Pool Co. tools

Spudding Date 8-5-54

Drlg. Data Oil well TD 3415

8" @ 250 Top. 2923 Heeb. 3155

Tor. 3173 Lans. 3196 DST 3160-3214

open 1 hr. Rec. 150' ocm 495#

DST 3282-93 open 1 hr. Rec. 10' mud

0# DST 3350-3415 open 1 hr. Rec.

120' muddy sw 0# TD 3415 5" @ 3414

CO to 3333 8/ 3303-05 1000 A 34 bfpd

15 bo 19 bw P/ 4 bo 100 bwpd

reperf/ 24/ 3292-96 S/ 1 boph SP 3270

36/ 3253-59 1000A B/ 5 go 1 hr.

24/ 3231-37 1000 A S/ 1½ boph PB 3228

36/ 3211-17 1000 A S/ 2½ boph PB 3205

36/ 3172-78 250 A 24/ 3198-3202 1000 A

S/ 125' fluid 1 hr. CO to 3270

FABEN GILSTRAP

Drlg. Data

S/ 105' oil 5' wtr. 1 hr. S/ 2½ bo

7 gw 1 hr. CO to 3298/ FU 140' oil

50' wtr. 1 hr. Comp. 24 bopd 10% wtr.

Misc.
Pierce Map
Trance Map
Tracings
Land Wall Map
Land Small Map
Court Cards

NOV 2 1954