

KANSAS

Rooks

FORM 51 25M 3-49 PETROL

Section 3 Township 10 Range 17-WWell No. #1 ElvaCompany Phillips & Cities Service

NORTH

WEST

EAST

SOUTH

0							

4

Sec. 3 Twp. 10 R. 17-W

Well No. #1 Elva Farm

Phillips & Cities Service Company


Nettie Phillips Contr.

330 Ft. from N. Line

 Ft. from S. Line

 Ft. from E. Line

330 Ft. from W. Line

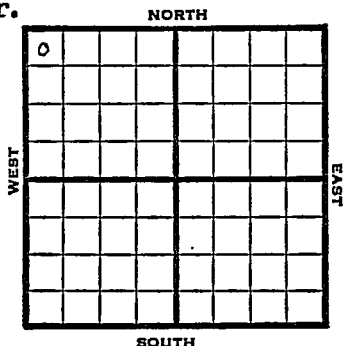

NW NW NW

1950

Elev. 2095' REPORT

7/26

Location

10/11

Spud 7-27-50

Oil Well TD 3520'

Anhy 1325'

8" @ 3170' Howard 2972'

Top 2998' Heeb 3192' Toronto 3214'

Lans. 3232' BKG 3465' Arb. 3509-3514'

5" @ 3512' TD 3514' FU 200' oil
2 hr.

DD 3515 FU 480 oil 2 hrs DD 3520

FU 1200' oil S/2 3/4 boph 1000A

P/249 BO P/120 BO 12 hr.

2000 A Comp. 267 BOPD 30 bw

COMPLETED

Kansas


Nettie Pool

Map No. _____ Sec. 3 Twp. 10 R. 17WWell No. 1 Elva_____
Phillips & Cities Service Company_____
Contractor

NW NW NW

330 Ft. from N. Line_____
Ft. from S. Line_____
Ft. from E. Line330 Ft. from W. Line

SECTION PLAT

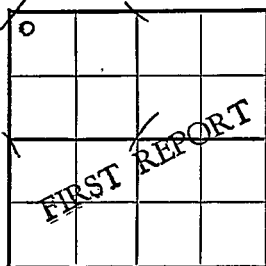

Rooks County

Location X

Rig up _____

Drilling and Remarks:

RECORD

Cased _____ in., _____ ft.

Sand _____

Gas _____

Oil _____

Total Depth _____

PRODUCTION

1st 24 hrs. Nat. _____

1st 24 hrs. after shot _____

Gas _____ Cu. Ft.

Dry Hole _____

Abandoned _____

Date


JUL 26 1950 19J. E. TYRA Scout

County _____ Rooks _____ State Kansas
 Sec. 3 (Blk.) 10 (Sur.) 17W Map No. _____
 (Twp.) _____ (Rge.) _____

Operator Phillips & Cities Service

Well No. 1 Farm Elva

Elev. 2095 Location NW NW NW

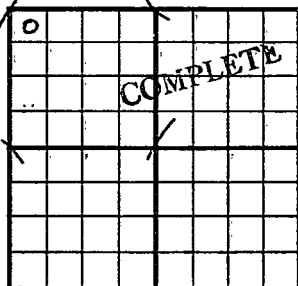

330 Ft. From N Line NW

330 Ft. From W Line Quarter

Ist. Report _____

Completion OCT 11 1950

Remarks Nettie Pool

Phillips - Contr.

Spudding Date 7-27-50

Drlg. Data Oil well TD 3520

Anhy 1325 8" @ 3170 Howard 2972

Top. 2998 Heeb. 3192 Toronto 3214

Lans. 3232 B KC 3465 Arb. 3509-3514

5" @ 3512 TD 3514 FU 200' oil 2 hr.

DD 3515 FU 480' oil 2 hr. DD 3520

FU 1200' oil S/ 2 3/4 boph 1000 A

P/ 249 bo P/ 120 bo 12 hr. 2000 A

Comp. 267 bopd 30 bw

J. E. TYRA