
FORM 51 10M 8-47

KANSAS — Rooks

Section 3 Township 10 Range ~~17W~~ 15

Well No. #1 J. Loreg

Company H. H. & B. Drlg.

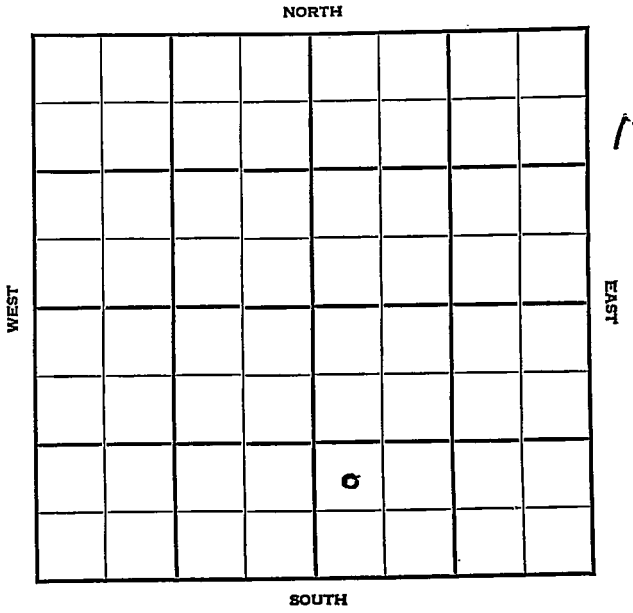

FORM 252-A
5M 9-47 PETROL


KANSAS Rooks ✓

Sec. 3 Twp. 10 R. 17W

Well No. #1 J. Loreg Farm

H. H. & B. Drlg. Company

Wildcat

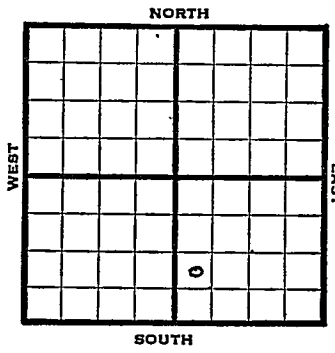

____ Ft. from N. Line

990 Ft. from S. Line

____ Ft. from E. Line

330 Ft. from W. Line

NW SW SE

1948 Elev.2085' REPORT

1/21 Location
1/26 8"@ 147'
Drlg 1845'

2/4 Lansing 3235'
Drlg. 3405'

2/11 Simp. 3513'
Arb. 3537'
TD 3568'
Abd.

ABANDONED

Form 26 200 Bks. 10-46 Petrol

Kansas

Wildcat

Map No. ____ Sec. 3 Twp. 10 R. 17W


Well No. 1 J. Loreg

H. H. & B. Drlg. Company

FIRST REPORT Contractor

NW SW SE

SECTION PLAT

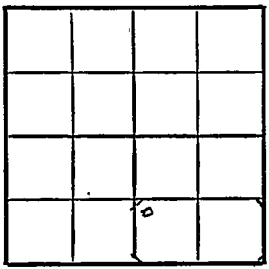

____ Ft. from N. Line

990 Ft. from S. Line

____ Ft. from E. Line

330 Ft. from W. Line

Rooks County

Location x

Rig up

Drilling and Remarks:

RECORD

Cased ____ in., ____ ft.

Sand

Gas

Oil

Total Depth

PRODUCTION

1st 24 hrs. Nat.

1st 24 hrs. after shot

Gas ____ Cu. Ft.

Dry Hole

Abandoned

Date

JAN 21 1948 19

S. J. LEWIS Scout

Form 26 200 Bks. 10-46 Petrol

Wildcat

Kansas

Map No. 64 Sec. 3 Twp. 10 R. 17W

Well No. 1 J. Loreg


H. H. & B. Drlg. Company

ABANDONED Contractor

NW SW SE

E12085

SECTION PLAT

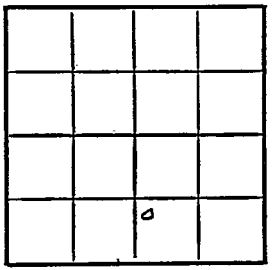

Ft. from N. Line

990 Ft. from S. Line

Ft. from E. Line

330 Ft. from W. Line

Rooks County

Location

Rig up

Drilling and Remarks:

Spud 3573

RT 3567

RECORD

Cased in., ft.

Sand

Gas

Oil

Total Depth 3568

PRODUCTION

1st 24 hrs. Nat.

1st 24 hrs. after shot

Gas Cu. Ft.

Dry Hole

Abandoned

Date 12-13 11

DEC 23 1947 19

S. J. LEWIS Scout