


Section 3 Township 10 Range 17 W

Well No. # 2 Elva

Company Phillips Pet.

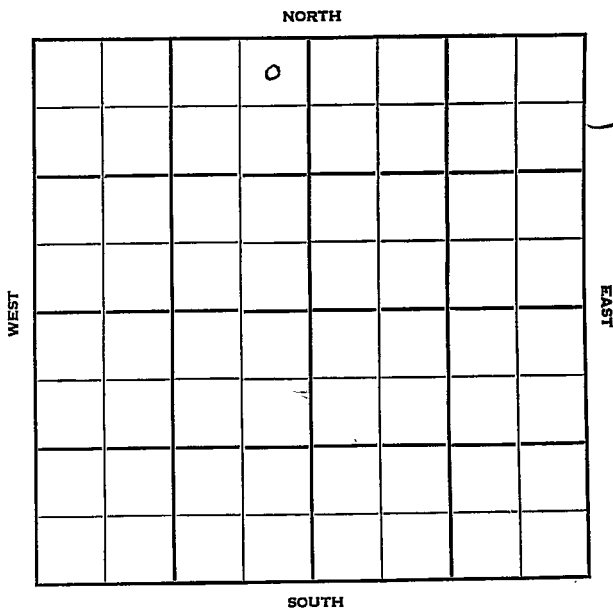

Rooks

KANSAS

Sec. 3 Twp. 10 R. 17W

Well No. #2 Elva Farm

Phillips Pet. Company

Phillips - Contr. Contractor

Nettie Pool


330' Ft. from N. Line

Ft. from S. Line

330' Ft. from E. Line

Ft. from W. Line

NE NE NW

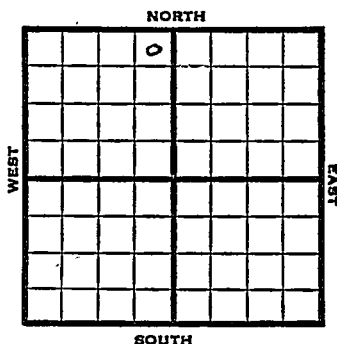

1951 Elev. 2048' REPORT

4/25 MIR

7/11 Spud 4-30-51
Oil Well TD 3493
8" @ 1329
Howard- 2930 Top 2954
Heeb. 3151 Lans. 3191
BKC 3426 Arb. 3487
TD 3492 5" @ 3488
DD 3493 300 A
S/4 bo FU 500' oil 2 hrs
S/30 bo 110 bw 10 hr SP 3426
20/3281-86 8/3288-90
8/3290-92 12/3292-95 500 A
S/21 bo 42 bw 6 hr 1500 A
S/42 bo 6 bw 5 hr. SP 3271
44/3242-52 500 A S/39 bo 14½ bw
3000A S/6 bo 66 bw 13 hr.
25/3227-33 S/56 bo 35 bw 13 hr.
PB 3237 3000 A S/51 bo 38 bw
18 hr. DP 3418 S/27 bo 22 bw
Comp. 89 bo 172 bwpd

COMPLETED

County Roos State Kansas
 Sec. 3 (Blk. 10 (Sur. 17W Map No.
 (Twp.) (Rge.)
 Operator Phillips Pet.
 Well No. 2 Farm Elva
 Elev. Location NE NE NW

			0				

FIRST REPORT

330 Ft. From N Line NW330 Ft. From E Line Quarter1st. Report APR 25 1951

Completion

Remarks


Phillips - Contr.

Spudding Date

Drlg. Data Nettie PoolM I R

J. E. TYRA

County Rooks State Kansas
 Sec. 3 (Blk. 10 (Sur. 17W Map No.
 (Twp. (Rge.
 Operator Phillips Pet.
 Well No. 2 Farm Elva
 Elev. 2048 Location NE NE NW

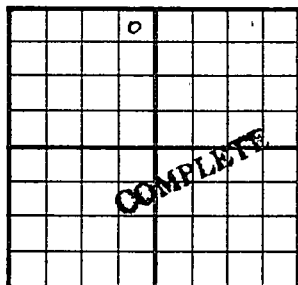

330Ft. From N Line NW
330Ft. From E Line Quarter
 Ist. Report
 Completion JUL 11 1951
 Remarks Nettie Pool
Phillips - Contr.
 Spudding Date 4-30-51

Drlg. Data Oil well TD 3493
8" @ 1329 Howard 2930 Top. 2954
Heeb. 3151 Lans. 3191 B KC 3426
Arb. 3487 TD 3492 5" @ 3488
DD 3493. 300 A S/ 4 bo FU 500'
oil 2 hr. S/ 30 bo 110 bw 10 hr.
SP 3426 20/ 3281-86 8/ 3288-90
8/ 3290-92 12/ 3292-95 500 A
S/ 21 bo 42 bw 6 hr. 1500 A
S/ 42 bo 6 bw 5 hr. SP 3271
44/ 3242-52 500 A S/ 39 bo 14 $\frac{1}{2}$ bw
3000 A S/ 6 bo 66 bw 13 hr.
25/ 3227-33 S/ 56 bo 35 bw 13 hr.
PB 3237 3000 A S/ 51 bo 38 bw
18 hr. DP 3418 S/ 27 bo 22 bw
Comp. 89 bo 172 bw pd

J. E. TYKA