


Section 3 Township 10 Range 17 W

Well No. # 6 Elba

Company Phillips

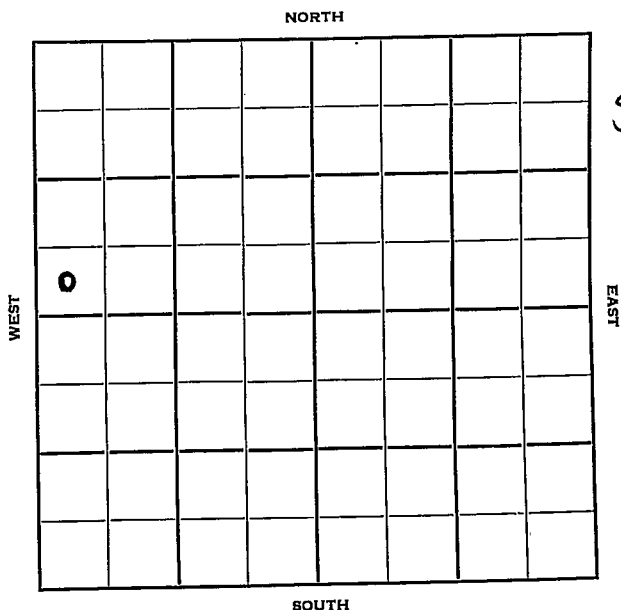

Sec. 3 Twp. 10 R. 17WWell No. #6 Elba FarmPhillips CompanyPhillips - Contr. Contractor

Ft. from N. Line

330'


Ft. from S. Line

Ft. from E. Line

330'

Ft. from W. Line

SW SW NW

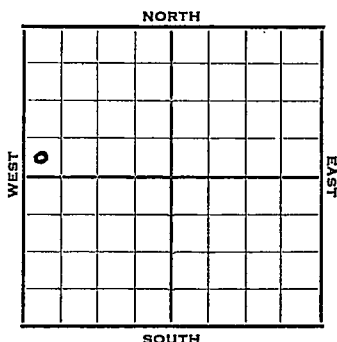

1952

Elev. 2087' REPORT

8/27

MIR

9/3

8" @ 324

Howard 2967

Topeka 2994

Heeb. 3188

Tor. 3206

Lans. 3230

Simp sh 3503

Simp sd 3508

Arb. 3521

RTD 3525 5" @ 3522½

9/10

CO 3500' 28/3453-60 500 A S/8

BO 5 hrs. 2000 A S/31 BO 12 hrs.

PB 3445 12/3434-38 S/1 BO 2 hrs.

1500 A S/4 BOPH for 4 hrs

DO 3483' Set plug 3423' 12/3412-15

8/3408-10 S/4½ BO 1 hr. 12/3397-3400

2000 A S/72 BO 10 hrs. DO 3485'

Set plug 3350' 44/3329-40 1500 A

S/70 BO plus 62 BW 10 hrs.

9/17

PB 3265' 16/3237-41 12/3230-33

500 A DO 3492 16/3294-98

16/3374-78 S/68 BO plus 52 BW 6 hrs.

POP

9/24

NR

10/1

"

10/8

Spud 8-23-52

Oil Well TD 3525

8" @ 324' Howard 2967 Top. 2994

Heeb. 3118 Tor. 3206 Lans. 3230

Simp. sh 3503 Simp. sd 3508

OVER
OVER

1952

10/8

Arb. 3521 TD 3525 5" @ 3522
CO to 3500 28/ 3453-60
500 A S/ 8 bo 5 hr. 2000 A
S/ 31 bo 12 hr. PB 3445
12/ 3434-38 S/ 1 bo 2 hr.
1500 A S/ 4 boph DO to 3483
SP 3423 12/ 3412-15 8/ 3408-10
S/ $4\frac{1}{2}$ bo 1 hr. 12/ 3397-3400
2000 A S/ 72 bo 10 hr. DO to
3485 SP 3350 44/ 3329-40
1500 A S/ 70 bo 62 bw 10 hr.
PB 3265 16/ 3237-41 12/ 3230-33
500 A DO to 3492 16/ 3294-98
16/ 3374-78 S/ 68 bo 52 bw 6 hr.
Comp. 204 bopd 68 bw

COMPLETED

J. G. McGEHEE

County _____ Rocks _____ State Kansas
 Sec. 3 (Blk. 10) (Sur. 17W) Map No. _____
 Operator Phillips Pet.
 Well No. 6 Farm Elba
 Elev. 2087 Location SW SW NW

330 Ft. From S Line NW

330 Ft. From W Line Quarter

1st. Report

Completion OCT 8 1952

Remarks

Phillips Pet. - Contr.

Spudding Date 8-23-52

Drlg. Data Oil well TD 3525

8" @ 324 Howard 2967 Top. 2994

Heeb. 3188 Tor. 3206 Lans. 3230

Simp. shh. 3503 Simp. sd. 3508

Arb. 3521 TD 3525 5" @ 3522 CO to 3500

28/ 3453-60 500 A S/ 8 bo 5 hr.

2000 A S/ 31 bo 12 hr. PB 3445

12/ 3434-38 S/ 1 bo 2 hr. 1500 A

S/ 4 boph DO to 3483 SP 3423 12/ 3412-

15 8/ 3408-10 S/ 4 1/2 bo 1 hr. 12/ 3397

3400 2000 A S/ 72 bo 10 hr. DO to

3485 SP 3350 44/ 3329-40 1500 A

S/ 70 bo 62 bw 10 hr. PB 3265

16/ 3237-41 12/ 3230-33 500 A

DO to 3492 16/ 3294-98 16/ 3374-78

J. G. McGEHEE

Drlg. Data

S/ 68 bo 52 bw 6 hr.

Comp. 204 ddpd

SEP 17 1962

Scout Cards
Land Small Map
Land Wall Map
Land Map
France Map
Pence Map
Misc