


DX 78-1 Rooks

KANSAS

Section 3 Township 10 Range 19W

Well No. #1 Sparks

Company Strata Drlg

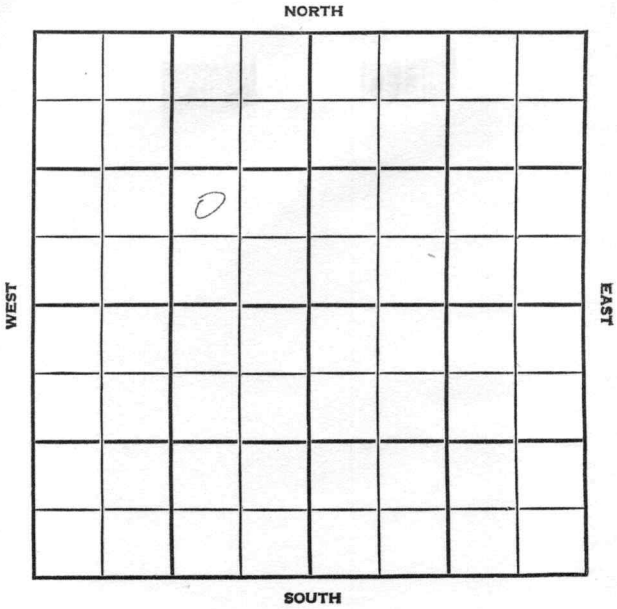

SEC. 3	TWP. 10	R. 19W
-----------	------------	-----------

WELL NO.

#1 Sparks

FARM

COMPANY

Strata Drlg.

CONTRACTOR


\_\_\_\_\_ FT. FROM N. LINE

\_\_\_\_\_ FT. FROM S. LINE

\_\_\_\_\_ FT. FROM E. LINE

\_\_\_\_\_ FT. FROM W. LINE

NW SE NW

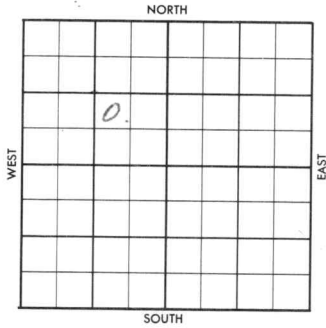

Phillips - DHM

	ELEVATION	REPORT
1956	2170'	
		3700' test
6-6	Location	
7-18	Comm. 6-24-56 8 5/8" @ 207 w/150 DST 3358-3412 op 1 hr, rec. 1965' MSW, BHP 1195/20". FP 275-950# DST 3534-66 op 30 min, rec. 25' mud, BHP 65/20". DST 3591-3628 op 30 min, rec. 50' mud, 760/20" D & A How. 3116'; Tp. 3142'; H. 3326'; Tr. 3348' KC 3366'; BKC 3571'; A. 3691'; Log tops: How. 3114'; Tp. 3140'; H. 3326'; Tr. 3348'; KC. 3364'; BKC 3579'; Marm 3599'; C. 3606'; S.Sh. 3644'; S. Dolo 3650'; A. 3683'; TD 3730'	
		<b>ABANDONED</b>



County Rocks Elev. 2170  
 Sec. 3 Twp. 10 Rge. 19W  
 Company Strata Oil  
 Farm Name Sparks No. 1

TOPS	DEPTH	LOG	DATUM	Loc. in Sec.
Anh. <u>How</u>	<u>3116</u>	<u>3114</u>		NW SE NW
Tp.	<u>3142</u>	<u>3140</u>		
H.	<u>3326</u>	<u>3326</u>		3700' test
Tr.	<u>3348</u>	<u>3348</u>		
Dg.				
Bl.				
L.				Geol.
K.C.	<u>3366</u>	<u>3364</u>		
B.K.C.	<u>3571</u>	<u>3579</u>		Contr.
Ce. <u>Marm</u>		<u>3599</u>		
C.		<u>3606</u>		
M.				Pool
M.				
K.				
Mz.				
Me.				
V.				
S. <u>SA</u>		<u>3644</u>		ABANDONED
S. <u>Dolo</u>		<u>3650?</u>		
A.	<u>3691</u>	<u>3683</u>		
R.				
PE.				JUL 18 1956
G.				
T.D.	<u>3730</u>			

Date Comm. Phillips - DHM  
 Location JUN 13 '56 JUN 20 '56 ✓ JUN 27 '56

6-24-56 8 5/8 207/1150 JUL 3 '56  
DST 3358-3412 1hr rec 1965' MSW  
BHP 1195/20 FP 275-950  
DST 3534-66 30" rec 25' Md  
BHP 65/20" ID 3610 JUL 11 '56 DST  
3591-3628 30" rec 50' Md.  
(SSA) 760/20"  
D&A (hold for log)  
 JUL 18 '56