


SECTION 3 TOWNSHIP 10 RANGE 20 W

WELL NO. #1 Nutsch

COMPANY Okmar Oil

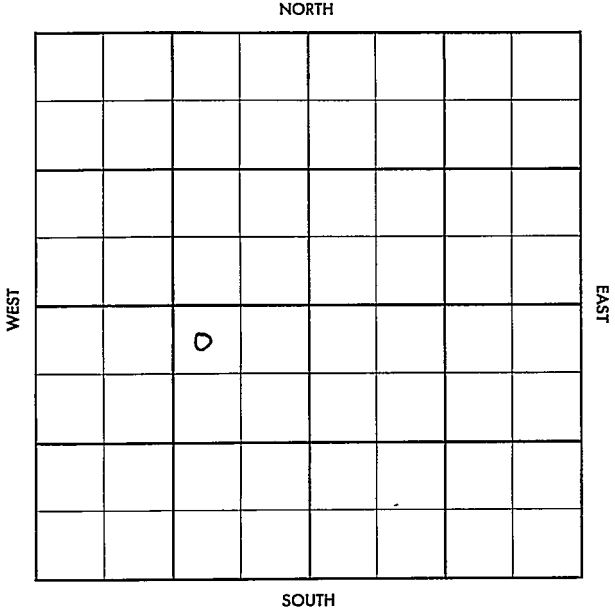

Rooks

KANSAS


SEC.	TWP.	R.
3	10	20W

WELL NO. #4 Nutsch FARM

COMPANY Okmar Oil

CONTRACTOR Walters
Marcotte

_____ Ft. from N. Line
 _____ Ft. from S. Line
 _____ Ft. from E. Line
 _____ Ft. from W. Line

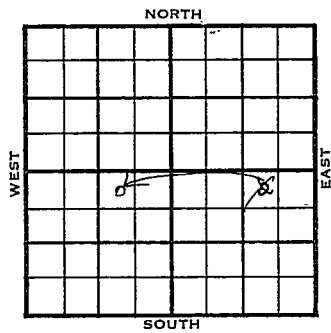

NW NE SW

	ELEVATION	REPORT
1955	2239'	
11/16	Comm 11-14-55 8 5/8" @ 174/125 WOC	
1956		
1-18	DST 3277-3310 op 1 hr. rec. 125' mw, 990# DST 3521-45 op 1 hr. rec. 2040' oil 1125/20" DST 3554-70 op 1 hr. rec. 10' mud, 0# DST 3574-85 op 1 hr. rec. 550' oil, 240' hocm, 680' sw, 1200/15" DST-3620-46 op- 1 hr. rec. 70' hocm 1000/15" DST 3646-60 op 1 hr. rec 210' ocm, 180' ocw, 180' sw, 560/15" DST 3662-75 op 36 min. rec. 10' mud, 60# DST 3678-3700 op 1 hr. rec. 60' mud, 750/15" DST 3790-3800 op 1 hr. rec. 2500' oil # 1030/15" 5 1/2" @ 3790, CO to 3800, FU 2700' oil 3 hrs. Comp. 315 bopd, 10% wtr. Anh. 1719, Tp. 3250 H. 3456 Tr. 3479 L. 3496 A. 3788, TD 3800'	

COMPLETED
DX-78

County Rooks Elev. 2239
 Sec. 3 Twp. 10N Rge. 20W
 Company Okmar Oil
 FarmName Nutsch No. 4

TOPS	DEPTH	LOG	DATUM	Loc. in Sec.
Anh.	1719			NW NE SW
Tr.	3250			
H.	3456			
Tr.	3479			
Dg.				
Bl.				
L.	3496		1257	Geol.
K.C.				Contr.
B.K.C.				Walters
Ce.				Pool
C.				Marcotte
M.				
M.				
K.				
Mz.				
Ma.				
V.				
S.				
S.				COMPLETE
A.	3788		-1549	
R.				
Pe.				
G.				
T.D.	3800			

JAN 18 1956

Date Comm. 8 5/8" @ 174/125 DST 3277-3310 open 1 hr.
rec. .125' mw 990# EST 3521-45
open 1 hr. rec. 2040' oil 1125/20"
DST 3554-70 open 1 hr. rec. 10' mud
off . DST 3574-85 open 1 hr. .rec.
550' oil . 240' hocm 680' sw 1200/15"
DST-3620-46 open 1 hr. rec. 70' hocm
1000/15" DST 3646-60 open 1 hr.

OVER

rec. 210' ocm 180' ocw 180' sw
560/15" DST 3662-75 open 36 min.

rec. 10' mud 60# DST 3678-3700

open 1 hr. rec. 60' mud 750/15"

DST 3790-3800 open 1 hr. rec. 2500' oi

1030/15" 5 $\frac{1}{2}$ " @ 3790. GO to 3800

FU 2700' oil 3 hr.

Comp. 315 bopd 10% wtr.

R. G.

JAN 27 1956