


Section 3 Township 10 Range 20 W
Well No. # 1 ~~Nutsch~~ ~~Nuech "B"~~
Company FRANCIS O. I + GAS
~~M. B. Armer~~

NORTH

WEST

EAST

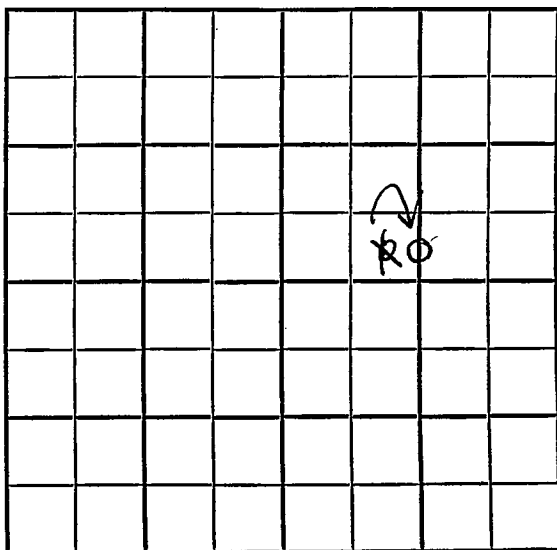

SOUTH

Rooks KANSAS

SEC. 3	TWP. 10	R. 20W
WELL NO. NUTSCH ~~1 Neuch "B"~~		
COMPANY FRANCIS O+G ~~M. B. Armer~~		FARM
CONTRACTOR Armer Wildcat		


_____ Ft. from N. Line

330 _____ Ft. from S. Line

_____ Ft. from E. Line

~~990~~ **1320** _____ Ft. from W. Line

C 3/2 S/2 NE
~~SE SW NE~~

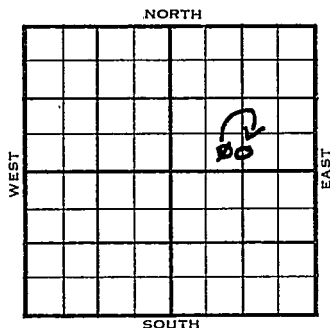

	ELEVATION	REPORT
1954	2271'	
7/28	Spdg 7-25-54 8" @ 211 WOC	
9/1	Spud 7-25-54 Oil well TD 3847 8" @ 211 Heeb 3508 Tor. 3528 Lans. 3547 Arb. 3840 TD 3847 5" @ 3845 DD 3848 S/8 BOPH DST 3626-63 open 1 hr rec 20' OCM, 120' oil wtr. 1050# DST 3681-3732 open 1 hr rec 25' mud 290# DST 3841-47 open 1 hr rec 1764' oil 5' muddy oil. 750# S/15 BOPH 4 hr. Comp. 433 BOPD	
	COMPLETED	


Kansas

Map No. _____ Sec. 3 Twp. 10 R. 20WWell No. 1 Nutsch

Francis Oil & Gas Company

CORRECTION ContractorQ S $\frac{1}{2}$ S $\frac{1}{2}$ NE

SECTION PLAT

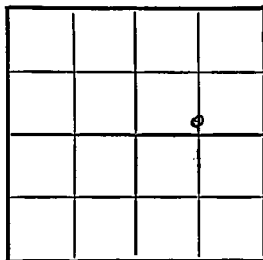

_____ Ft. from N. Line

330 Ft. from S. Line

_____ Ft. from E. Line

1320 Ft. from W. Line

Rooks County

Location _____

Rig up _____

Drilling and Remarks:

Reported
M. B. Armer
#1 Nuech "B"
SE SW NE

RECORD

Cased _____ in., _____ ft.

Sand _____

Gas _____

Oil _____

Total Depth _____

PRODUCTION

1st 24 hrs. Nat. _____

1st 24 hrs. after shot _____

Gas _____ Cu. Ft.

Dry Hole _____


Abandoned _____

Date

AUG 4 1954

J. G. McGEHEE

Scout

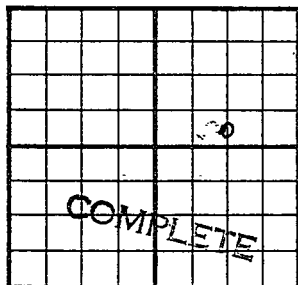County _____ Rocks _____ State KansasSec. 3 (Blk.) 10 (Sur.) 20W Map No. _____
(Twp.)Operator Francis Oil & GasWell No. 1 Farm NutschElev. 2271 Location C S $\frac{1}{2}$ S $\frac{1}{2}$ NE330 Ft. From S Line NE1320 Ft. From W Line Quarter

1st. Report _____

Completion SEP 1 1954Remarks WildcatArmer - Contr.Spudding Date 7-25-54Drlg. Data Oil well TD 38478" @ 211 Heeb. 3508 Tor. 3528Lans. 3547 Arb. 3840 TD 38475" @ 3845 DD 3848 S/ 8 bophDST 3626-63 open 1 hr. Rec. 20' ocm120' oily wtr. 1050# DST 3681-3732open 1 hr. Rec. 25' mud 290# DST 3841-47 open 1 hr. Rec. 1764' oil 5' muddyoil 750# S/ 15 boph 4 hr.Comp. 433 bopd

FABEN GILSTRAP