


Section 3 Township 10 **KANSAS** Range 20W

Well No. #1 Nutsch

Company Heathan & Co.

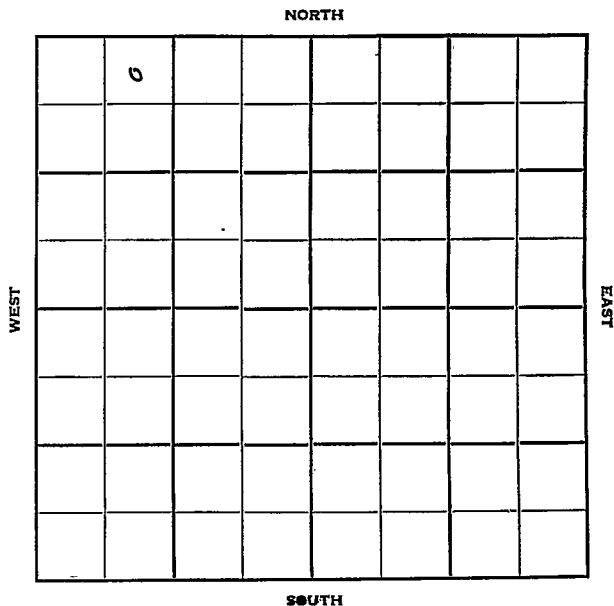

Rooks

KANSAS

Sec. 3 Twp. 10 R. 20W

Well No. #1 Nutsch Farm

Heathman & Co. Company

Contractor

Palco Pool


330' Ft. from N. Line

_____ Ft. from S. Line

_____ Ft. from E. Line

990' Ft. from W. Line

NE NW NW

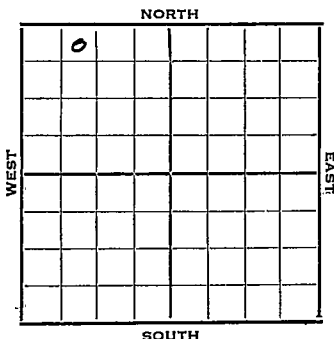

1951 Elev. 2252' REPORT

11/28

RUR

12/12

Spud 11-28-51

D&A TD 3930

8" @ 151

Heeb. 3500 KC 3539

B KC 3666 Cong. 3807

Simp. 3862 Arb. 3880

TD 3930

D&A

ABANDONED

County Rooks State KansasSec. 3 (Blk. Twp.) 10 (Sur. Rge.) 20W Map No.Operator Heathman & Co.Well No. 1 Farm WutschElev. Location NW NW NW

0						

330 Ft. From N Line NW990 Ft. From W Line Quarter1st. Report NOV 28 1951

Completion

Remarks

Spudding Date

Drlg. Data Palco PoolR U RJ. E. TYRA

County Books State **Kansas**

Sec. 3 (Blk. Twp.) 10 (Sur. Rge.) 20W Map No.

Operator Heathman & Co.

Well No. 1 Farm \ Nutsch

Elev. 2252 Location NE NW NW

0

ABANDONED

330 Ft. From N Line NW

990 Ft. From W Line Quarter

1st. Report

Completion DEC 1 2 1957

Remarks	Palco Pool
---------	------------

Spudding Date 11-28-51

Drig. Data D & A TD 3930

8" @ 151 Heeb. 3500 KC 3539

B. KC 3666 Cong. 3807 Simp. 3862

Arb. 3880 TD 3930

D & A

J. E. TYRA