


Section 3 Township 10 Range 21 W

Well No. #1
#7 Miller

Company Anderson-Prichard

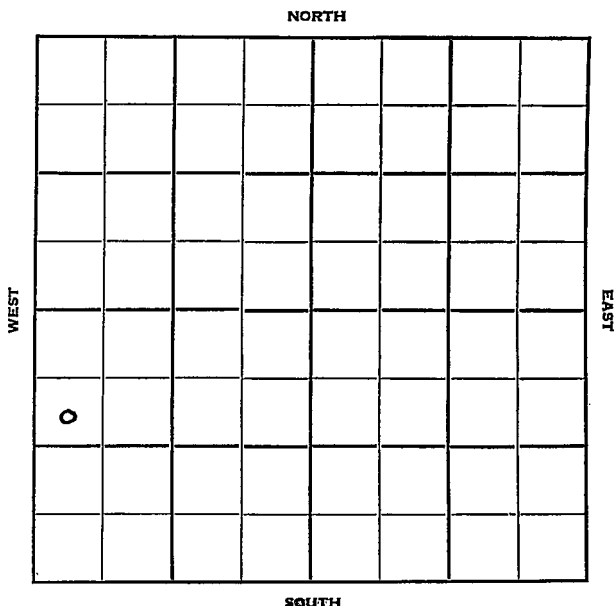

Sec. 3 Twp. 10 R. 21W ✓

Well No. #1 ~~#7~~ Miller Farm

Anderson-Prichard Company

B&B Drlg. - Contr. Contractor

Cooper Pool


990' Ft. from N. Line

Ft. from S. Line

Ft. from E. Line

330' Ft. from W. Line

SW NW SW

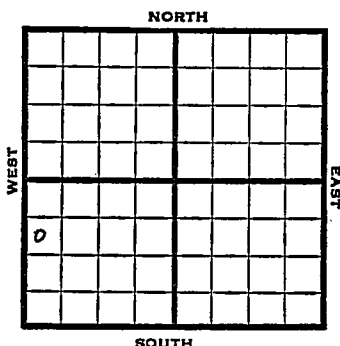

1951

Elev. 2276' REPORT

1/17

Spud 1-10-51
8" @ 237'
Anhy 1753-90
Drlg. 2360'


1/24

Spud 1-10-51
D&A TD 3889'
8" @ 237' Anhy 1753-90
Heeb. 3500 Lans. 3538
Cong. 3820 Arb. 3871
DST 3872-77 opn 1 hr Rec. 30' mud
DST 3870-89 opn 1/2 hr Rec. 1500'
wtr TD 3889' D&A

ABANDONED

J. E. TYRA

County Graham State Kansas
 Sec. 3 (Blk. 10 (Sur. 21W Map No.)
 Operator Anderson-Prichard
 Well No. 7 Farm Miller
 Elev. 2276 Location SW NW SW

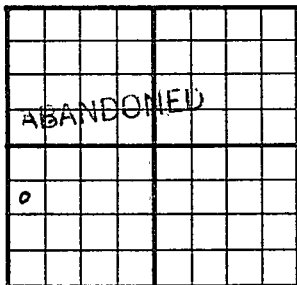

990 Ft. From N Line SW
330 Ft. From W Line Quarter
 Ist. Report
 Completion JAN 24 1951
 Remarks Cooper Pool
B & B Drlg. - Contr.
 Spudding Date 1-10-51

Drlg. Data D & A TD 3889
8" @ 237 Anhy 1753-90 Heeb. 3500
Lans. 3538 Cong. 3820 Arb. 3871
DST 3872-77 open 1 hr. Rec. 30' mud
DST 3870-89 open $\frac{1}{2}$ hr. Rec. 1500' water
TD 3889 D & A

J. E. TYRA

O. W. D. D

FORM 513 SUNRAY

County Graham Elev. _____
 Sec. 3 Twp. 10 Rge. 21W
 Company Anderson-Prichard
 Farm Name Miller No. 1

TOPS	DEPTH	LOG	DATUM	Loc. in Sec.
Anh.				SW NW SW
Tp.				(OWDD) For
H.				SWDW Was #7
Tr.				Geol.
Dg.				Contr.
BL.				Glen Peel
L.				Pool
K.C.				
B.K.C.				
Ce.				
C.				
M.				
M.				
K.				
Mz.				
Ma.				
V.				
S.				
S.				
A.				
R.				
Pe.				
G.				
TD	OTD	3889		FIRST REPORT

Date Comm. 5" @ 3998

New Info - DD to 4300 TD, WOC

8

Co.

County Graham Elev. 2276 DF
 Sec. 3 Twp. 10 Rgs. 21W
 Company Anderson-Prichard
 Farm Name Miller No. 1

TOPS	DEPTH	LOG	DATUM	Loc. in Sec.
Anh. <u>4</u>	<u>1753</u>			SW NW SW
TP.				(OWDD) For
H.	<u>3500</u>			SWDW Was #7
Tr.				Geol.
Dg.				Contr.
BL.				Glen Peel
L.	<u>3538</u>			Pool <u>COOPER</u>
K.C.				
B.K.C.				
Ce.				
C.	<u>3820</u>			
M.				
M.				
K.				
Mz.				
Mq.				
V.				
S.				
S.				
A.	<u>3871</u>			ABANDONED
R.				
PE.				
G.				
TD.	<u>OTD</u>	<u>3889</u>		

L.S.

No.

Sec.

T.

R.

Date Comm. 5" @ 3998

New Info - DD to 4300 TD, WOC JUL 10 '57 JUL 17 '57

MICT CO JUL 24 '57 CO 4300

12 completeinput 3 Bwp minute ~~as 4300~~
comp. for SWD.