


Section 3 Township 10 Range 21-W

Well No. #4 Miller

Company Anderson - Prichard

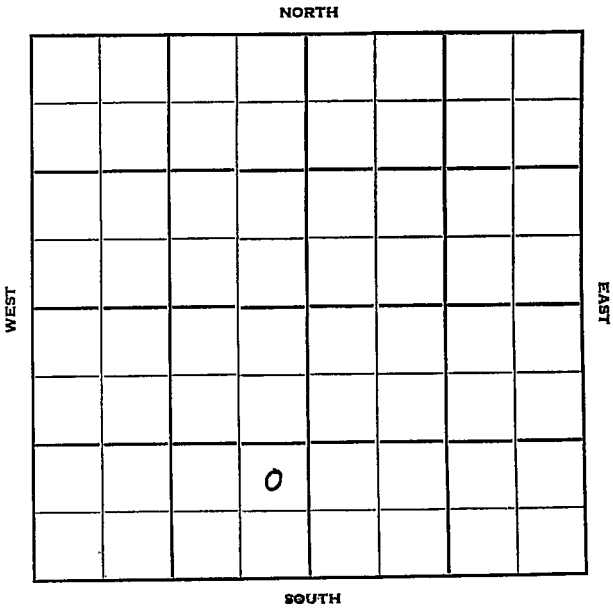

Graham

KANSAS

Sec. 3 Twp. 10 R. 21W ✓

Well No. #4 Miller Farm

Anderson-Prichard Company

Contractor

NE Teel Pool.

Ft. from N. Line

990'


Ft. from S. Line

330'

Ft. from E. Line

Ft. from W. Line

NE SE SW

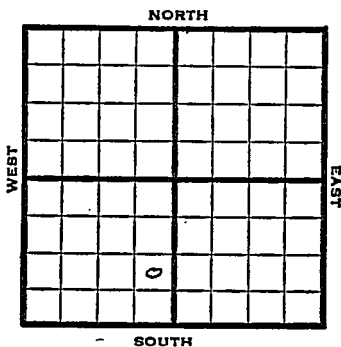

1950

Elev. 2295' REPORT

11/15

Location

12/27

Spud 11-15-50

Oil Well TD 3852

8-5/8" @ 265 Anhy 1778

Heeb. 3496 Lans. 3534

Simp. 3843 Arb. 3849-52

5" @ 3850 TD 3852

S/8 boph FU 2750' oil 45 min

S/70 boph

DST 3706-40 opn 1/2 hr Rec. 30' wtr

& mud Comp. Ind. cap 4138 bopd

COMPLETED

