


Section 3 Township 10 Range 21 W

Well No. #2 Morel

Company Phillips Petroleum

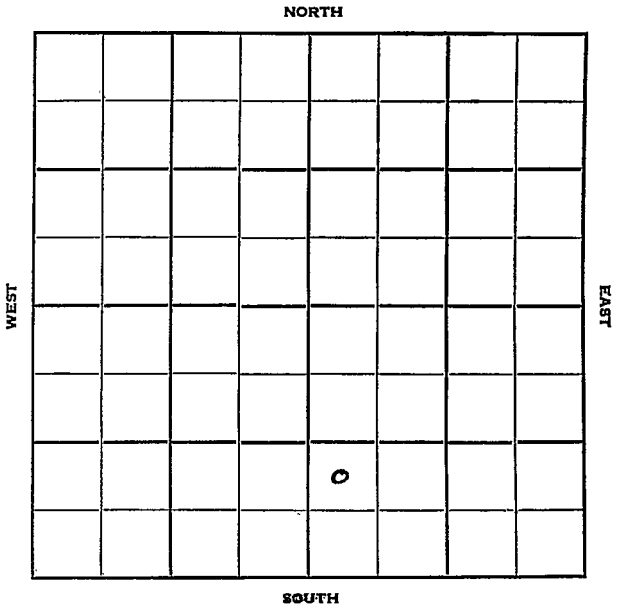

Graham KANSAS
IO R. 21W ✓

Sec. 3 Twp. IO R. 21W

Well No. #2 Morel Farm

Phillips Petroleum Company


Jones-Shelborne - Contr. Contractor
Cooper Pool

_____ Ft. from N. Line

990' _____ Ft. from S. Line

_____ Ft. from E. Line

330' _____ Ft. from W. Line

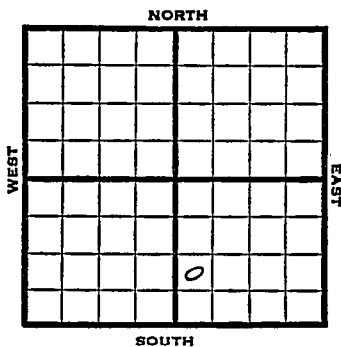

NW SW SE

1951 Elev. 2297' REPORT

1/17 Spud 1-11-51
Anhy 1780'
8" @ 1830
Drlg. 2480'

2/28 Spud 1-11-51
Oil Well TD 3869
Anhy 1780 8" @ 1830
Howard 3293
Topeka 3323 Heeb. 3502
Toronto 3523 Lans. 3541
Arb. 3857
TD 3853 5" @ 3860
FU 500' oil DD 3865
FU 1150' oil 1 hr
S/7 boph DD3869
S/51 bo 1 hr
S/61 bo 2nd hr; Comp. 3000 bopd

COMPLETED

