


Section 3 Township 10 Range 21W

Well No. #5 Morel

Company Phillips Pet.

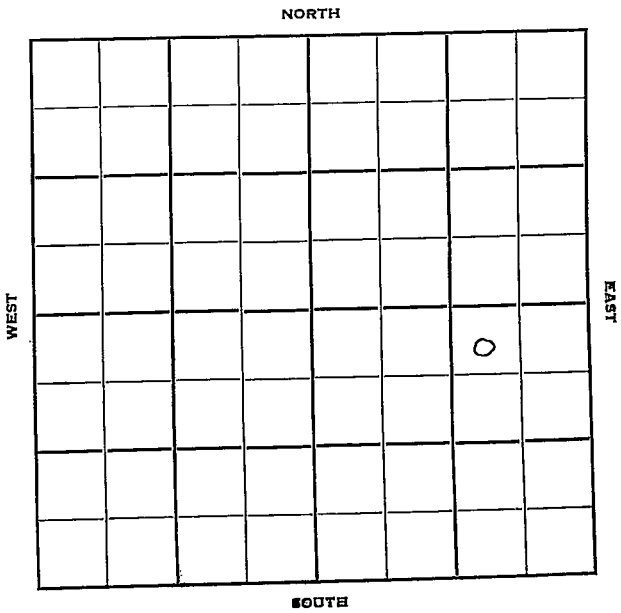

Graham

KANSAS

Sec. 3 Twp. 10 R. 21 W

Well No. # 5 Morel Farm

Phillips Pet. Company

Phillips Contractor

Cooper Pool


330 Ft. from N. Line

_____ Ft. from S. Line

990 Ft. from E. Line

_____ Ft. from W. Line

NW NE SE

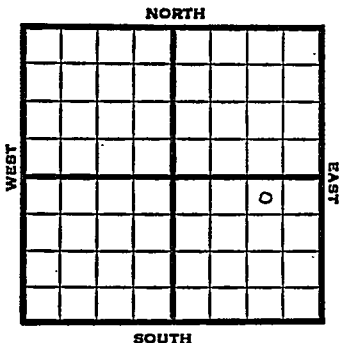

1951

Elev. 2301' REPORT

8/15

Location

10/17

Oil Well TD 3836
 8" @ 1784 Howard 3285
 Top. 3310 Heeb. 3489
 Tor. 3510 Lans. 3527
 BKC 3754 Arb. 3828
 TD 3830 5" @ 3828
 DD 3836 FU 2300' oil 1 hr
 S/64 bo 1 hr P/136 bo 8 hr.
 Comp. Echo Pot. 3000 bopd

COMPLETED

County Graham State Kansas

Sec. 3 (Blk.) 10 (Sur.) 21W Map No.

Operator Phillips Pet.

Well No. 5 Farm Morel

Elev. 2301 Location NW NE SE

330 Ft. From N Line SE

990 Ft. From E Line Quarter

Ist. Report

Completion OCT 17 1951

Remarks Cooper Pool

Phillips - Contr.

Spudding Date

Drlg. Data Oil well TD 3836

8" @ 1784 Howard 3285 Top. 3310

Heeb. 3489 Tor. 3510 Lans. 3527

B. KC 3754 Arb. 3828 TD 3830

5" @ 3828 DD 3836 FU 2300' oil 1 hr.

S/ 64 bo 1 hr. P/ 136 bo 8 hr.

Comp. Echo Pot. 3000 bopd

J. E. TYRA