


Graham

KANSAS

Section 3 Township 10 Range 21WWell No. #1 TribbleCompany Phillips Pet.

NORTH

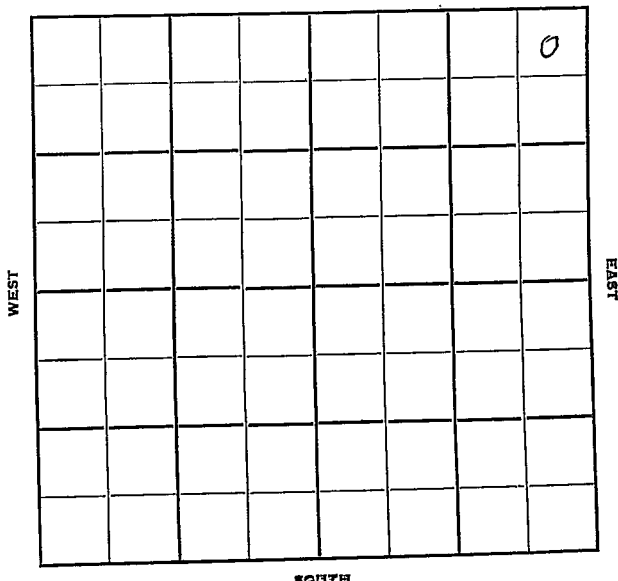

KANSAS

Graham

Sec. 3 Twp. 10 R. 21-W

Well No. #1 Tribble Farm

Phillips Petroleum Company

Phillips Petroleum Contractor


DeYoung
330 Ft. from N. Line

Ft. from S. Line

330 Ft. from E. Line

Ft. from W. Line

NE NE NE

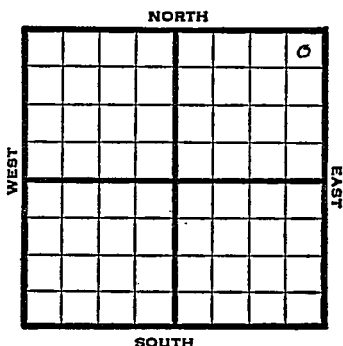

1950

Elev 2294

REPORT

8/30

Spud 8-26-50
drlg 1520

10/4

8" @ 1479

Anhy 1776

Howard 3489

Top 3308

Heeb 3489

Toronto 3513

Lans 3532

B KC 3756

Arb 3847

TD 3861

5" @ 3848 FU 1260' oil 1 hr

S/10 boph 4 hr S/84 boph

Comp draw down pot. 3000 bopd

Completed

COMPLETED

County Graham State KansasSec. 3 (Blk. 10 (Sur. 21W Map No.Operator Phillips PetroleumWell No. 1 Farm TribbleElev. 2294 Location NE NE NE

330 Ft. From N Line NE330 Ft. From E Line Quarter1st. Report AUG 30 1950

Completion

Remarks

Spudding Date 8-26-50Drlg. Data DeYoung Pooldrlg. 1520

J. E. TYRA



Sec. 3 (Blk. Twp.) 10 (Sur. Rge.) 21W Map No.

Well No. 1 Farm Tribble

Elev. 2294 Location NE NE NE

330 Ft. From N Line NE

330 Ft. From E Line Quarter

Ist. Report

Completion OCT 4 1950

Remarks DeYoung Pool

Phillips Petroleum - Cont

Spudding Date 8-26-50

Drlg. Data Oil well TD 3861

8" @ 1479 Anhy 1776 Howard 3489

Top. 3308 Heeb. 3489 Toronto 3513

Lans. 3532 BKC 3756 Arb. 3847

TD 3861 5" @ 3848 FU 1260' oil 1 nr.

S/ 10 boph 4 hr. S/ 84 boph

Comp. draw down pot. 3000 bopd

J. E. TYRA