

Section **3** Township **10** Range **21W**Well No. **#9 Miller**Company **Anderson-Prichard**

NORTH

WEST

EAST

	0						

SOUTH

Graham

KANSAS

Sec. 3 Twp. 10 R. 21W

Well No. #9 Miller Farm

Anderson-Prichard Company

Peel Drlg. Contractor

Cooper Pool


Ft. from N. Line

330 Ft. from S. Line

Ft. from E. Line

990 Ft. from W. Line

SE SW SW

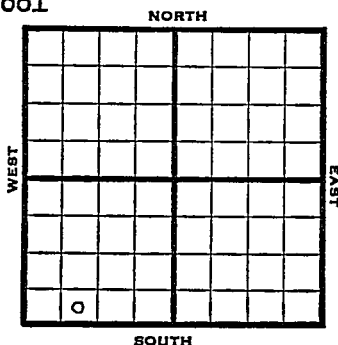

1951 Elev. 2240' REPORT

12/5 Spud 11-29-51
8" @ 198'
Anhy 1705'
Drlg. 2857'

1952
1/9 Spud 11-29-51 Oil well TD 3905'
8" @ 198 Anhy 1705' Heeb 3440'
KC 3480'
DST 3504-34 open 1 hr. rec 27' mud
Cong. 3755' Simp. 3788' Arb. 3807'
DST 3809-22 open 20 min. rec 1440' oil
150' OCM
DST 3825-42' open 15 min. rec 783' OCSW
TD 3905' 5" @ 3904 24/3826-32
S/29 BO 47 BW 14 hr. 24/3804-08
24/3808-11 S/54 BO 30 BW 12 hr.
S/6 BFPH 25% water.
Comp. 96 BOPD 24 % water

COMPLETED

County **Graham** State **Kansas**

Sec. **3** (Blk. Twp.) **10** (Sur. Rge.) **21W** Map No.

Operator **Anderson-Prichard**

Well No. 9 Farm Miller

Elev. 2240 Location SE SW SW

FIRST REPORT

330 Ft. From S Line SW

990 Ft. From W Line Quarter

1st. Report DEC 5 1951

Completion

Remarks

Peel Drlg. - Contr.

Spudding Date **11-29-51**

Drlg. Data	Cooper Pool
------------	-------------

8" @ 198 Anhy 1705 drlg. 2857



Operator Anderson-Prichard

Well No. 9 Farm Miller

Elev.	2240	Location	SE SW SW
-------	------	----------	----------

A 10x10 grid with the word "COMPLETE" diagonally across the center and a small circle in the bottom-left corner.

330 Ft. From S Line SW

990 Ft. From W Line Quarter

1st. Report

Completion **JAN 9 1952**

Remarks	Cooper Pool
---------	-------------

Peel Drlg. - Contr.

Spudding Date 11-29-51

Drilg. Data Oil well TD 3905

8" @ 198 Anhy 1705 Heeb. 3440

KC 3480 DST 3504-34 open 1 hr.

Rec. 27' mud Cong. 3755 Simp. 3788

Arb. 3807 DST 3809-22 open 20 min.

Rec. 1440' oil 150' ocm DST 3825-42

open 15 min. Rec. 783' ocsw TD 3905

5" @ 3904 24/ 3826-32 S/ 29 bo 47 bw

14 hr. , 24/ 3804-08 , 24/ 3808-11 ;

S/ 54⁵ bo 30 bw 12 hr: S/ 6 bfph.

25% water Comp. 96 bopd 24% water

J. E. TYRA