


Section 3 Township 10 Range 21 W

Well No. #10 Miller

Company Anderson-Prichard

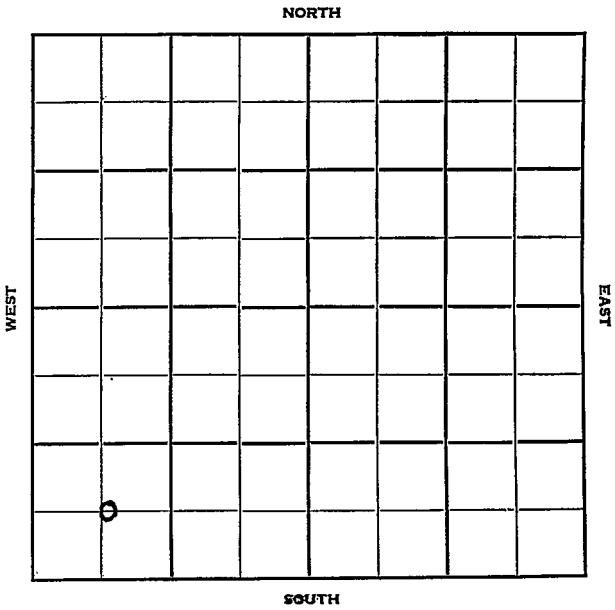

Sec. 3 Twp. 10 R. 21W

Well No. #10 Miller Farm

Anderson-Prichard Company

Peel - Contr. Contractor

Cooper Pool


Ft. from N. Line

660' Ft. from S. Line

Ft. from E. Line

715' Ft. from W. Line

C SW SW (Twin well)

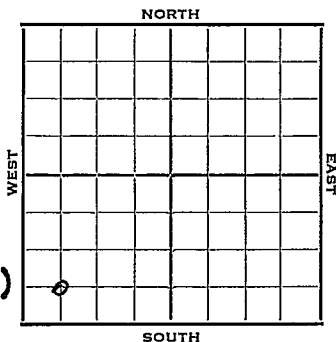

1952

Elev. 2251'

REPORT

3/19

Spud 3-17-52
8" @ 200
WOC

3/25

Anhy 1715'
Drlg. 3470'

4/1

Heeb. 3457 Lans. 3497
Cong. 3767 Simp. 3808
Arb. 3821 RTD 3824
5" @ 3822 WOC

4/9

DP to 3824 S/ 1 1/2 bfpH 90% wtr.
250 A S/ 4 1/2 BFPH

4/23

S/2 BFPH 90% water for 8 hrs.
S/96 BO plus 6 BW 8 hrs.

4/30

POP P/120 BO & 15% wtr 20 hrs.

5/7

Spud 3-17-52
Oil well TD 3824' 8" @ 200
Anhy 1715' Heeb 3457' Lans. 3497'
Cong. 3767' Simp. 3808' Arb. 3821'
TD 3824' 5" @ 3822' DP to 3824'
S/1 1/2 BFPH 90% water 250 A S/4 1/2 BFPH
S/2 BFPH 90% water S/56 BO 4 BW 8 hr.
Comp. 137 BOPD 15% water.

COMPLETED

