

Section 3 Township 10 Range 21WWell No. #3 TribbleCompany Phillips Petr.

NORTH

						0	

WEST

EAST

SOUTH

Graham

KANSAS ✓

Sec. 3 Twp. 10 R. 21W

Well No. #3 Tribble Farm

Phillips Petroleum Company

Contractor

Cooper Pool


990' Ft. from N. Line

 Ft. from S. Line

990' Ft. from E. Line

 Ft. from W. Line

SW NE NE

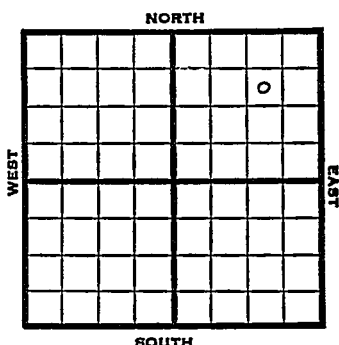


1951 Elev. 2286' REPORT

6/13 MIR

8/1 Spud 6-13-51 Oil well TD 3831'
8" @ 1668' Anhy 1770' Howard 3275'
Top. 3295' Heeb 3478' Tor 3498'
Lans. 3518' B KC 3741' Arb. 3821'
TD 3825' 5" @ 3821' S/20 BOPH
DD 3831' S/81 BOPH
Comp. 3000 BOPD

COMPLETED

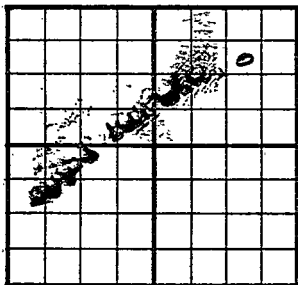County Graham State KansasSec. 3 (Blk. Twp.) 10 (Sur. Rge.) 21 W Map No.Operator Phillips PetroleumWell No. 3 Farm TribbleElev. Location SW NE NE990 Ft. From N Line NE990 Ft. From E Line Quarter1st. Report JUN 13 1951

Completion

Remarks


Spudding Date

Drlg. Data

MTRCooper: Pool

J. E. TYRA

County Graham State Kansas
 Sec. 3 (^{Blk.}Twp.) 10 (^{Sur.}Rge.) 21W Map No. _____
 Operator Phillips Petroleum
 Well No. 3 Farm Tribble
 Elev. 2286 Location SW NE NE

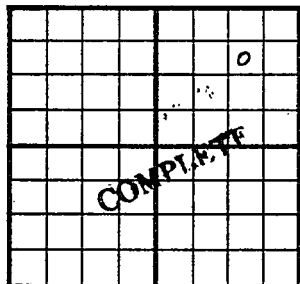

990 Ft. From N Line NE
990 Ft. From E Line Quarter
 Ist. Report _____
 Completion AUG 1 1951
 Remarks Cooper Pool

Spudding Date 6-13-51

Drig. Data Oil well TD 3831
8" @ 1668 Anhy 1770 Howard 3275
Top. 3295 Heeb. 3478 Tor. 3498
Lens. 3518 B KC 3741 Arb. 3821
TD 3825 5" @ 3821 S/ 20 boph DD 3831
S/ 81 boph Comp. 3000 bopd

J. E. TYRA