

Section 3 Township 10 Range 21 WWell No. # 6 TribbleCompany Phillips Pet.

NORTH

WEST

EAST

					0		

SOUTH

Graham

KANSAS

Sec. 3 Twp. 10 R. 21W

Well No. #6 Tribble Farm

Phillips Pet. Company

Cooper Pool


Ft. from N. Line

990' Ft. from S. Line

Ft. from E. Line

990' Ft. from W. Line

NE SW NE

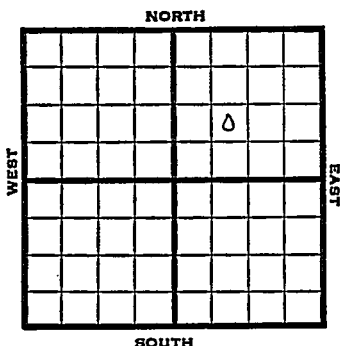

1951

Elev. 2300' REPORT

7/11

Location

8/8

Spud 7-15-51
D&A TD 3942
Anhy 1790 ...
8" @ 1806
Top 3315 Heeb. 3495
Tor. 3514 Lans. 3534
BKC 3762 Cong. 3857
Arb. 3887 TD 3942
DST 3655-3702 opn $\frac{1}{2}$ hr
Rec. 60' mud 420' wtr & mud
D&A

ABANDONED

County Graham State KansasSec. 3 (Blk.) 10 (Sur.) 21W Map No.Operator Phillips Pet.Well No. 6 Farm TribbleElev. Location NE SW NE


990 Ft. From S Line NE990 Ft. From W Line Quarter1st. Report JUL 11 1951

Completion

Remarks

Spudding Date

Drig. Data Cooper * poolLocationJ. E. TYRA

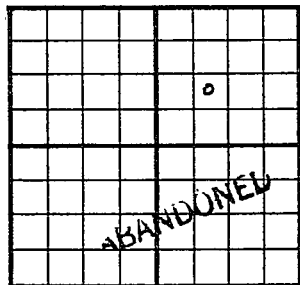County Graham State KansasSec. 3 (Blk.
Twp.) 10 (Sur.
Rge.) 21W Map No.Operator Phillips Pet.Well No. 6 Farm TribbleElev. 2300 Location NE SW NE990 Ft. From S Line NE990 Ft. From W Line Quarter

1st. Report

Completion AUG 8 1951Remarks Cooper PoolSpudding Date 7-15-51Drlg. Data D & A TD 3942Anhy 1790 8" @ 1806 Top. 3315Heeb. 3495 Tor. 3514 Lans. 3534B KC 3762 Cong. 3857 Arb. 3887TD 3942 DST 3655-3702 open $\frac{1}{2}$ hr.Rec. 60' mud 420' water & mudD & AJ. E. TYRA