
FORM 51 25M 3-49 PETROL Graham

KANSAS

Section 3 Township 10 Range 23W

Well No. #1 Klenk

Company Magnolia

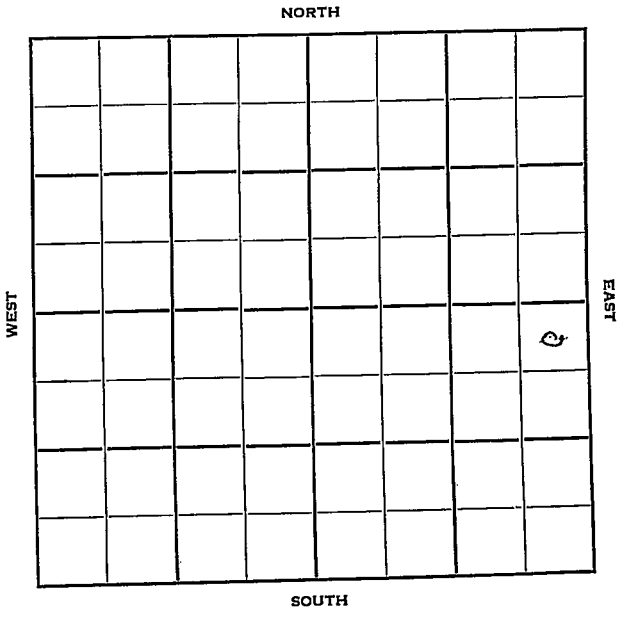

FORM 252-B
10M 8-51 TPCO.

Graham

KANSAS

Sec. 3 Twp. 10 R. 23W

Well No. #1 Klenk Farm

Magnolia Company

Contractor


330' Ft. from N. Line

Ft. from S. Line

330' Ft. from E. Line

Ft. from W. Line

NE NE SE

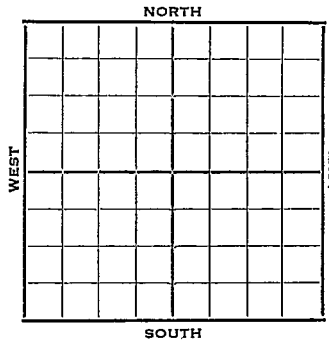

1952	Elev. 2425' REPORT
2/13	Location
2/20	13" @ 195' Drlg. 2425'
3/5	Marm 3993' Arb. 4234' TD 4257' Rung casing.
3/12	7" @ 4236' 54/4120-38 B/9 gal oil PH for 2 hr.
3/19	Strato-lift 4120-38 Test little oil POP
3/26	Spud 2-15-52 Oil Well TD 4257' 13" @ 195 Heeb. 3582 Lans. 3707 DST 3741-56 open 1 hr. rec. 330' hg 7 socm 330' ho &gcm 30' wtr. Marm. 3993' Arb. 4234 TD 4257 7" @ 4236 54/ 4120-38 B/ 9 goph 2 hr. Stratolift 4120-38 Test little oil Comp. 8 bopd 1% wtr.

COMPLETED

4234
3707
527

4234
2425
1809

FORM 275 FOR SALE BY KANSAS BLUE PRINT CO.


County Graham State Kansas

Sec. 3 (Blk. / Twp.) 10 (Sur. / Rge.) 23W Map No.

Operator Magnolia

Well No. 1 Farm Klenk

Elev. Location NE NE SE

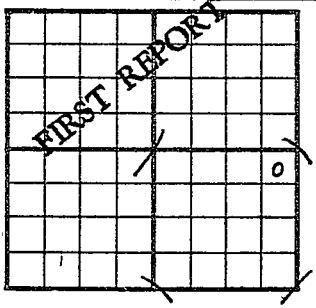

330 Ft. From N Line SE

330 Ft. From E Line Quarter

1st. Report FEB 13 1952

Completion

Remarks

Spudding Date

Drlg. Data Law S.

Location

J. G. McGEHEE

FORM 275 FOR SALE BY KANSAS BLUE PRINT CO.


County Graham State Kansas

Sec. 3 (Blk. Twp.) 10 (Sur. Rge.) 23W Map No.

Operator Magnolia

Well No. 1 Farm Klenk

Elev. 2425 Location NE NE SE

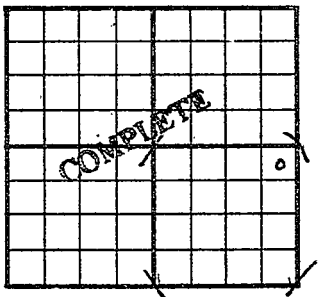

330 Ft. From N Line SE

330 Ft. From E Line Quarter

1st. Report

Completion MAR 2 6 1952

Remarks S. Law Pool

Spudding Date 2-15-52

Drlg. Data Oil well TD 4257

13" @ 195 Heeb. 3582 Lans. 3707

DST 3741-56 open 1 hr. Rec. 330' hg & socm 330' ho & gcm 30' water

Marm. 3993 Arb. 4234 TD 4257

7" @ 4236 54/ 4120-38 B/ 9 goph 2 hr.

Stratolift 4120-38 test little oil

Comp. 8 bopd 1% water

J. G. McGEHEE