Graham


DX 78-1

KANSAS

Section 3 Township 10 Range 23W

Well No. #1 Klenk

Company Trans Era.

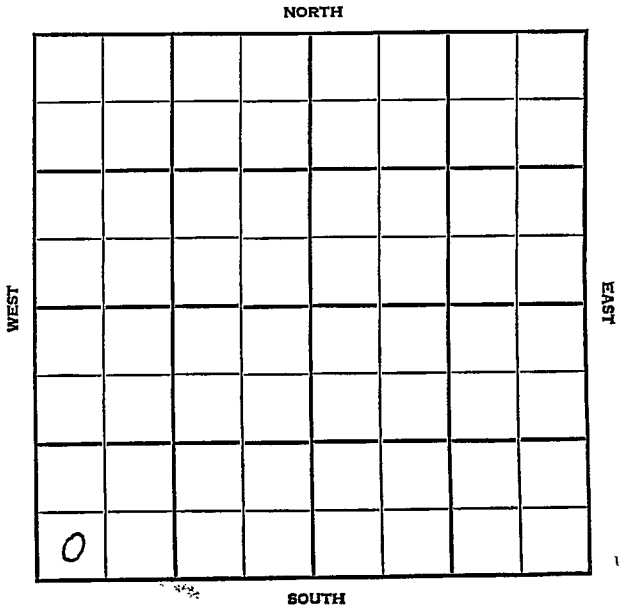

Graham

SEC.	TWP.	R. KANSAS
3	10	23W

WELL NO. #1 Klenk FARM

COMPANY Trans-Era

CONTRACTOR

Hoof Pool


NORTH

330 Ft. from N. Line

330 Ft. from S. Line

Ft. from E. Line

330 Ft. from W. Line

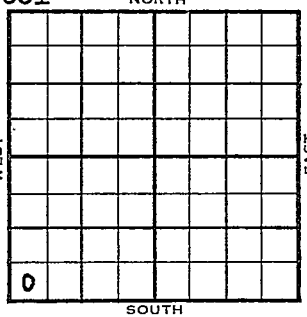

SW SW SW

	ELEVATION	REPORT
1955	2427'	
4/6		8" @ 226' Drlg. 910'
4/20		D & A TD 4173' 8" @ 226' Anhy 2005', Heeb 3711' KC 3744' DST 3746'-76' opn 1 hr, rec 88' wm 1100# DST 3762'-88' opn 1 hr, rec 62' salty wm, 1090# DST 3893'-3930' opn 1 hr, rec 10' drlg mud 0# B KC 3972' Marm 4088' Marm Sd. 4162' Cong. 4171' TD 4173' D & A ABANDONED

DX-78

FORM 275 FOR SALE BY KANSAS BLUE PRINT CO.


County Graham State Kansas

Sec. 3 (Blk. / Twp.) 10 (Sur. / Rge.) 23W Map No.

Operator Trans-Era

Well No. 1 Farm Klenk

Elev. Location SW SW SW

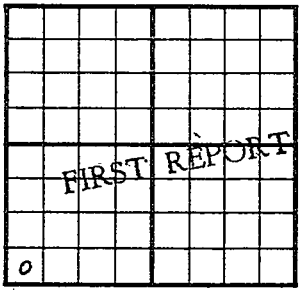

330 Ft. From S Line SW

330 Ft. From W Line Quarter

1st. Report APR 6 1955

Completion

Remarks

Spudding Date

Drlg. Data Hoof Pool

8" @ 226 drlg. 910

FABEN GILSTRAP

FORM 275 FOR SALE BY KANSAS BLUE PRINT CO.


County Graham State Kansas

Sec. 3 (Blk. Twp.) 10 (Sur. Rge.) 23W Map No.

Operator Trans-Era

Well No. 1 Farm. Klenk

Elev. 2427 Location SW SW SW

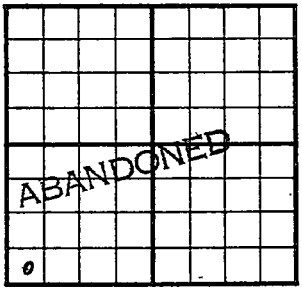

330 Ft. From S Line SW

330 Ft. From W Line Quarter

1st. Report

Completion APR 2 0 1955

Remarks Hoof Pool

Spudding Date

Drlg. Data D & A TD 4173

8" @ 226 Anhy 2005 Heeb. 3711

KC 3744 DST 3746-76 open 1 hr.

Rec. 88' wm 1100# DST 3762-88

open 1 hr. Rec. 62' salty wm 1090#

DST 3893-3930 open 1 hr. Rec. 10' drlg.

mud 0# B KC 3972 Marm. 4088

Marm. sd. 4162 Cong. 4171 TD 4173

D & A

FABEN GILSTRAP