


Section 30 Township 10 Range 19W

Well No. 1 Berland "B"

Company Texas

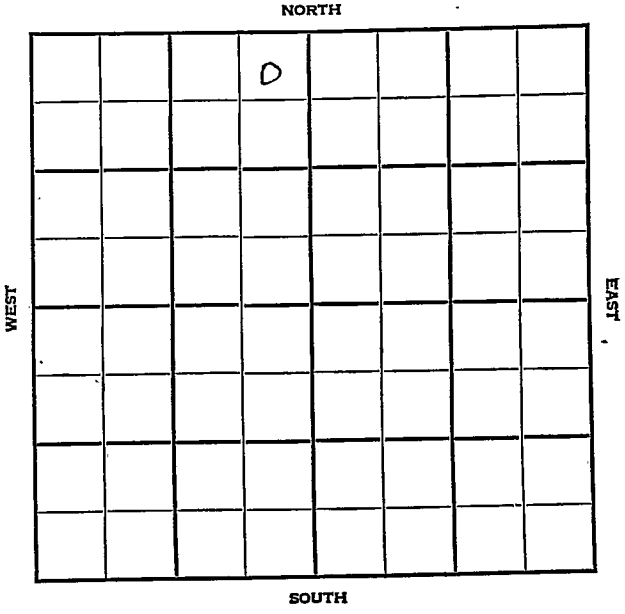

**KANSAS**

Rooks

Sec. ~~19~~ 20 Twp. 10 R. 19W ✓

Well No. #1 Berland "B" Farm \_\_\_\_\_  
Texas \_\_\_\_\_ Company \_\_\_\_\_

Berland Pool


330' Ft. from N. Line

\_\_\_\_\_ Ft. from S. Line

330' Ft. from E. Line

\_\_\_\_\_ Ft. from W. Line

NE NW

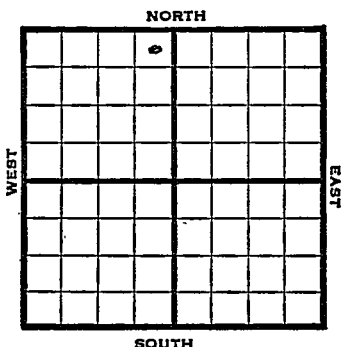

1948

Eli 2239'

REPORT

7/28	Drlg. 385'
7/28	"
8/4	8" @ 1631' Drlg. 2740'
8/11	Lansing 3487' Drlg 3768'
8/18	Arb. 3810 5" @ 3811' TD 3815 Swb 172 bbls oil 6 hrs.
8/25	"
9/1	"
9/8	"
9/15	Arb. 3810' 5" @ 3811' T <sup>D</sup> 3815' Pump 421 Oil / 4% W Pot 28° Gr. Comp

**COMPLETED**

Rooks County Kansas State

Map No. Sec. 19 Twp. 10 R. 19W

Well No. 1 Berland "B"

Texas Company

FIRST REPORT Contractor

NE NW

SECTION PLAT

		0			

330 Ft. from N. Line

Ft. from S. Line

330 Ft. from E. Line

Ft. from W. Line

Berland Pool

Remarks:

drlg. 385

Date JUL 28 1948

Scout S. J. LEWIS

Rooks County Kansas State

Map No. 65 Sec. 30 Twp. 10 R. 19W


Well No. 1 Berland "B"

Texas Company

CORRECTION Contractor

NE NW

SECTION PLAT

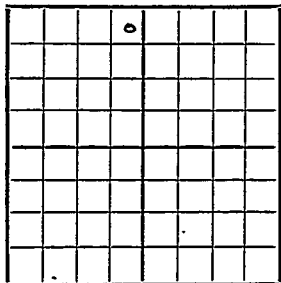

330 Ft. from N. Line

\_\_\_\_\_ Ft. from S. Line

330 Ft. from E. Line

\_\_\_\_\_ Ft. from W. Line

Berland Pool

Remarks:

Reported 19-10-19W

1  
 2  
Date 4 1948

Scout S. J. LEWIS

Rooks County Kansas State

Map No. 65 Sec. 30 Twp. 10 R. 19W

Well No. 1 Berland "B"

Texas Company

**COMPLETE**

NE NW Contractor

*E/ 2289*  
**SECTION PLAT**

330 Ft. from N. Line

       Ft. from S. Line

330 Ft. from E. Line

       Ft. from W. Line


Berland Pool

Remarks:

*Out 3870*

*5" @ 3871*

*7753875*

*Pump 4200ft + 4% W.C. 2.0PM*

*2892*

Date  
**SEP 15 1948**

Scout **S. J. LEWIS**