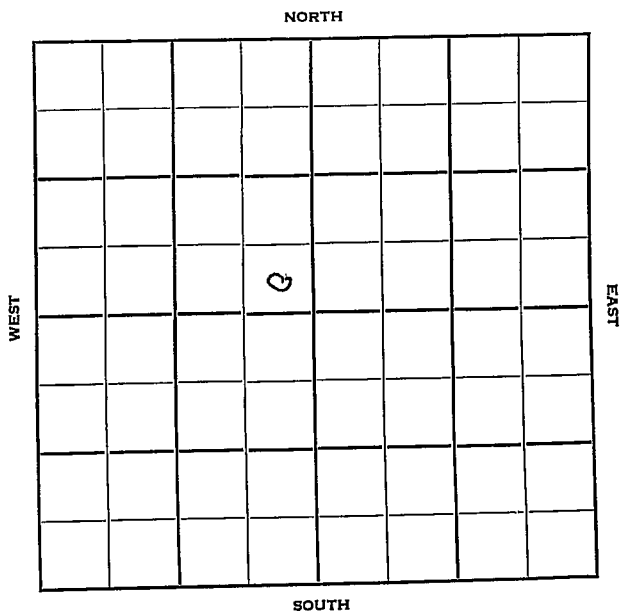


Section 30 Township 10 Range 20WWell No. #1 RaymondCompany B & B Drlg.

Rooks

KANSAS

Sec. 30 Twp. 10 R. 20W

Well No. #1 Raymond Farm

B & B Drlg. Company

B & B Drlg. Contractor

SE Laura Pool


Ft. from N. Line

330 Ft. from S. Line

330 Ft. from E. Line

Ft. from W. Line

NW $\frac{1}{4}$ SE SE NW

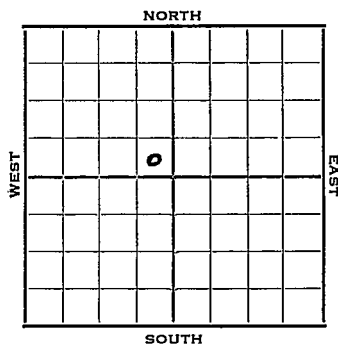


1952 Elev. 2092' REPORT

10/22 RUR
10/29 8" @ 167 Anhy 1590'
Drlg. 2971'
11/5 Spud 10-22-52
DA& TD 3710' 8" @ 167
Anhy 1590 Heeb. 3335
Tor. 3356 Lans. 3373
Cong. 3637
TD 3710' D&A

ABANDONED

J. G. McGEHEE

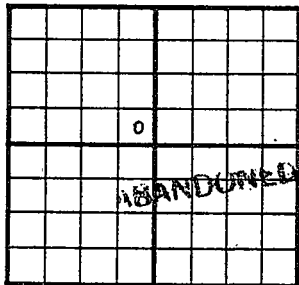County Rooks State KansasSec. 30 (Blk.
Twp.) 10 (Sur.
Rge.) 20W Map No.Operator B & B Drlg.Well No. 1 Farm RaymondElev. 2092 Location SE SE NW330 Ft. From S Line NW330 Ft. From E Line Quarter1st. ReportCompletion NOV 5 1952Remarks SE Laura PoolB & B Drlg. - Contr.Spudding Date 10-22-52Drlg. Data D & A TD 37108" @ 167 Anhy 1590 Heeb. 3335Tor. 3356 Lans. 3373 Cong. 3637TD 3710D & A

J. G. McGEHEE