


Section 30 Township 10 Range 20 W

Well No. # 2 Allphin

Company Sunray Oil

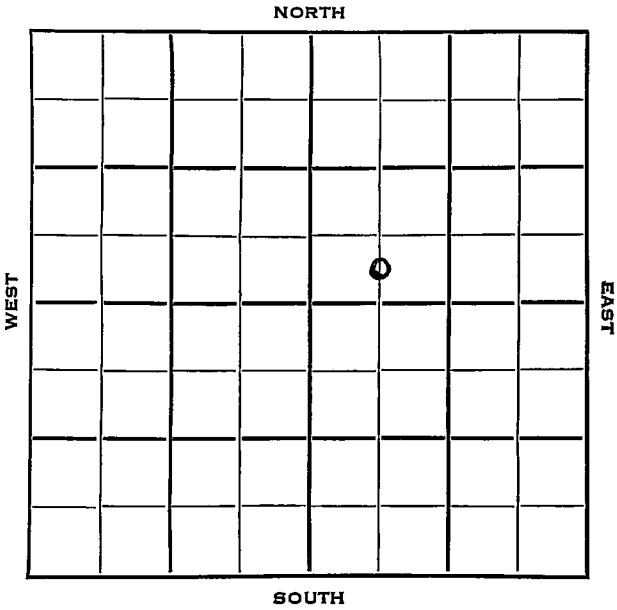

Sec. 30 Twp. 10 R. 20W

Well No. #2 Allphin Farm _____

Sunray Oil Company _____

Stickle Drlg. Contractor _____

SE Laura Pool


_____ Ft. from N. Line

330 Ft. from S. Line

_____ Ft. from E. Line

660 Ft. from W. Line

C S L SW NE

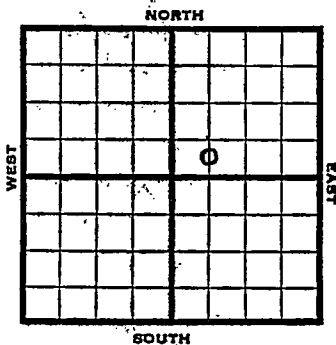

1953 Elev. 2082' REPORT

5/13 Spud 5-12-53

5/21 8" @ 274
Drlg. 3135'

5/28 Heeb 3325, Lans 3363
DST 3427-42 1 hr, 120' g & mco 420#
DST 3532-60 1 hr, 215' mco 30' sw
1160# Arb 3656
RTD 3663
5" @ 3658'

6/3 CO 3663 18½ goph 4 hrs, 500 A 9½ BO
5 Hrs. 1000 A S/ 5 boph POP

6/10 P/100 BO 8 Hrs.

6/24 Spud 5-12-53 Oil well TD 3663
8" @ 274 Heeb 3325' Lans 3363
DST 3427-42 open 1 hr rec 120' G &
MCO 420#
DST 3532-60 open 1 hr rec 215' MCO
30' SW 1160# Arb. 3656'
TD 3663 5" @ 3658 CO to 3663
18½ GOPH 4 hr. 500 A 9½ BO 5 hr.
1000 A 5 BOPH P/100 BO 8 hr.
Comp. 300 BOPD

COMPLETED

