

Rooks

DX 78-1

KANSAS

Section 30 Township 10 Range 20W

Well No. #2 Raymond 'A'

Company B & B Drlg.

NORTH

		0					

SOUTH

Rooks KANSAS

SEC.	TWP.	R.
30	10	20W ✓

WELL NO. 2 Raymond "A" FARM

COMPANY B & B Drlg.

CONTRACTOR B & B Drlg.


SE Laura Pool

330 Ft. from N. Line

990 Ft. from E. Line

Ft. from S. Line

Ft. from W. Line

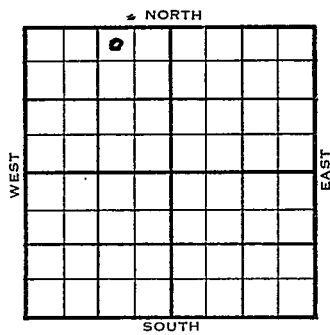

NW NE NW

1954	ELEVATION	REPORT
	2107'	

4/27 Spud 4-24-54
8" @ 159'
Anhy 1585'
Drlg. 2480'

5/5 Top 3132'
DST 3156-81, 1 hr, 400' SW 1050#
Heeb 3342' Tor 3366 Lans 3381
DST 3407-36, 1/2 hr, 350' SW 1100#
Arb. 3693'
DST 3696-79', 1 hr, 415' clean oil,
625# RTD 3699' 5" @ 3696'

5/12 CO 3699 FU 1500' oil 4 hrs. POP
5/19 WOP

6/23 Spud 4-24-54 - Oil Well
TD 3699'
8" @ 159'
Anhy 1585', Top 3132'
DST 3156-81', opn 1 hr., rec. 400' SW,
1050#
Heeb 3342', T or 3366', Lans 3381'
DST 3407-36', opn 1/2 hrs., rec. 350'
SW, 1100#
Arb. 3693'
DST 3696-99', 1 hr., rec. 415' clean
oil, 625#

(Information Brought Forward)

1954
6/23

TD 3699'

5" @ 3696'

CO to 3699'

FU 1500' oil oil 4 hrs.

Comp. 267 bopd 20% wtr.

COMPLETED

County _____ Rooks _____ State **Kansas**
 Sec. 30 - (Blk. Twp.) 10 (Sur. Rge.) 20W Map No. _____
 Operator **B & B Drlg.**
 Well No. 2 Farm **Raymond "A"**
 Elev. 2107 Location **NW NE NW**

COMPLETE

330 Ft. From N Line NW
 990 Ft. From E Line Quarter
 Ist. Report _____
 Completion **JUN 23 1954**
 Remarks **SE Laura Pool**
B & B Drlg. - Contr.
 Spudding Date **4-24-54**

Drlg. Data Oil well TD 3699
 8" @ 159 Anhy 1585 Top. 3132
 DST 3156-81 open 1 hr. Rec. 400' sw
 1050# Heeb. 3342 Tor. 3366 Lans. 3381
 DST 3407-36 open $\frac{1}{2}$ hr. Rec. 350' sw
 1100# Arb. 3693 DST 3696-99 open 1 hr.
 Rec. 415' clean oil 625# TD 3699
 5" @ 3696 CO to 3699 FU 1500' oil 4 hr.
 Comp. 267 bopd 20% wtr.