


Section 30 Township 10 Range 20W

Well No. #1 Schneider (B)

Company B & R Drlg.

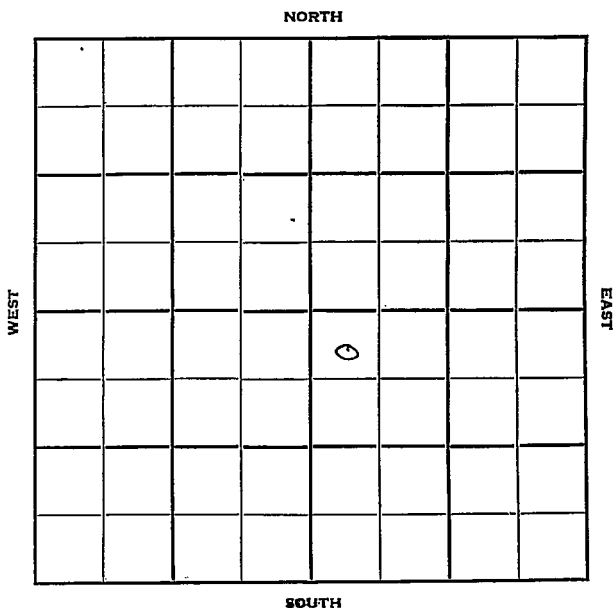

Sec. 30 Twp. 10 R. 20W

Well No. #1 Schneider (B) Farm

B & R Drlg. Company

Contractor


Wildcat

330 Ft. from N. Line

Ft. from S. Line

Ft. from E. Line

330 Ft. from W. Line

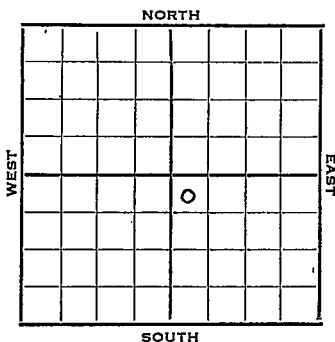

NW NW SE

Sunray FO

1952 Elev. 2089' REPORT

- 8/20 Spud 8-18-52  
8" @ 200'  
Drlg. 1130'
- 8/27 Heeb. 3338 Lans. 3380  
Drlg. 3405
- 9/3 DST 3456-64, 50 mins. 215' SW  
1190# SO 3568-72  
DST 3551-91, 1/2 hr. 30' SOCM  
1180# Cong. 3636 Arb. 3667  
TD 3672 5" @ 3668 1/2
- 9/10 CO 3672' 500 A 8 gal OPH DD 3673'  
TD 1000 A S/2 1/2 BOPH for 12 hrs.  
2500 A Fill up 2475' oil 8 hrs.  
S/27 BOPH for 16 hrs.
- 9/17 NR  
9/24 "
- 10/1 "
- 10/15 Spud 8-18-52  
Oil Well TD 3673'  
8" @ 200'  
Heeb. 3338 Lans. 3380  
DST 3456-64 open 50 min. rec. 215' SW  
1190# SO 3568-72  
DST 3551-91 open 1/2 hr. rec. 30'  
SOCM 1180# Cong. 3636 Arb. 3667

OVER

1952

10/15 TD 3672 5" @ 3668 CO to 3672  
500 A S/ 8 goph DD 3673  
1000 A S/  $2\frac{1}{2}$  boph 12 hr.  
2500 A FU 2475' oil 8 hr.  
S/ 27 boph 16 hr.  
Comp. 178 bopd

**COMPLETED**



