


Section 30 Township 10 Range 20 W

Well No. # 1 Schneider "C"

Company Trans - Era

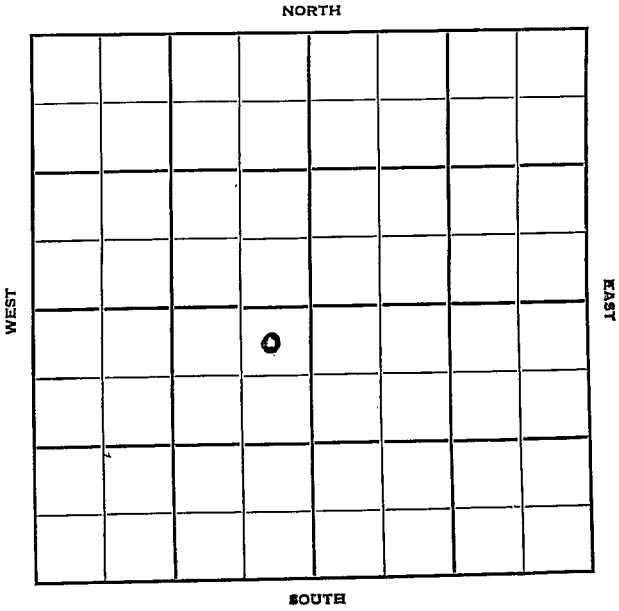

Sec. 30 Twp. 10 R. 20W ✓

Well No. #1 Schneider "C" Farm _____

Trans - Era

Company _____

"

Contractor _____

SE Laura Pool


330 Ft. from N. Line

_____ Ft. from S. Line

330 Ft. from E. Line

_____ Ft. from W. Line

NE NE SW

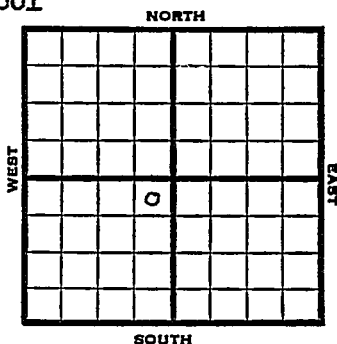

1952	2099 ¹ IS 2101 RB REPORT
10/8	Spud 9-25-52 8" @ 210' Anhy 1562 Heeb. 3337 Lans. 3381 SO 3469-76 3568-75 B KC 3601 Cong. 3636 Arb. 3670 TD 3672' 5" @ 3671'
10/15	Drlg. deeper 3673, 1500A S/2 $\frac{1}{2}$ BOPH 2500A, test 25 BOPH
10/22	POP
10/29	NR
11/5	P/ 478 BO 69 hrs.
11/12	Spud 9-25-52 Oil well TD 3673' 8" @ 210 Anhy 1562' Heeb 3337' Lans. 3381' SO 3469-73' 3568-75 B KC 3601' Cong. 3636' Arb. 3670' TD 3672' 5" @ 3671 DD 3673' F/46 GOPH 500 A S/1 BOPH 1000 A S/2 $\frac{1}{2}$ BOPH 2500 A 25 BOPH P/478 BO 69 hr. Comp. 448 BOPD
<p>COMPLETED</p>	

