


Section 30 Township 10 Range 20W

Well No. #3 Schneider "C"

Company Trans-Era

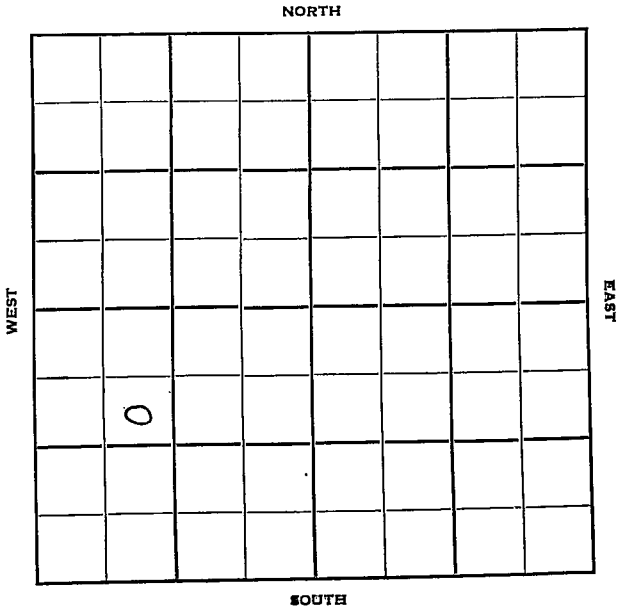



Sec. 30 Twp. 10 R. 20W

Well No. #3 Schneider "C" Farm

Trans-Era Company

B & R Drlg. Contractor

SE Laura Pool


990 Ft. from N. Line

_____ Ft. from S. Line

_____ Ft. from E. Line

990 Ft. from W. Line

SW 1/4 SE NW SW

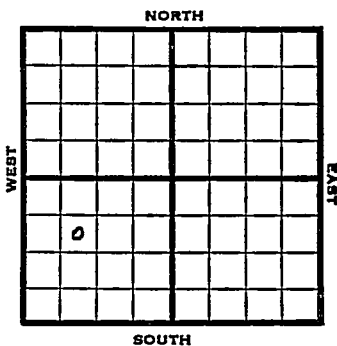

1952

Elev. 2157' REPORT

11/5 Spud 11-3-52
8" @ 198'

11/12 Heeb. 3411' KC 3453
Drlg. 3550'

11/19 Spud 11-3-52
D & A TD 3779' 8" @ 198
Heeb 3411' KC 3453' Cong. 3724'
TD 3779' D & A

ABANDONED

