


*Roche*  
*16<sup>th</sup>*

Map No. **KANSAS** Sec. *31* Twp. *10* R. *16<sup>th</sup>*

Well No. *F Bradley* Farm  
*Slick, Pryor & Lockhart* Company

NORTH

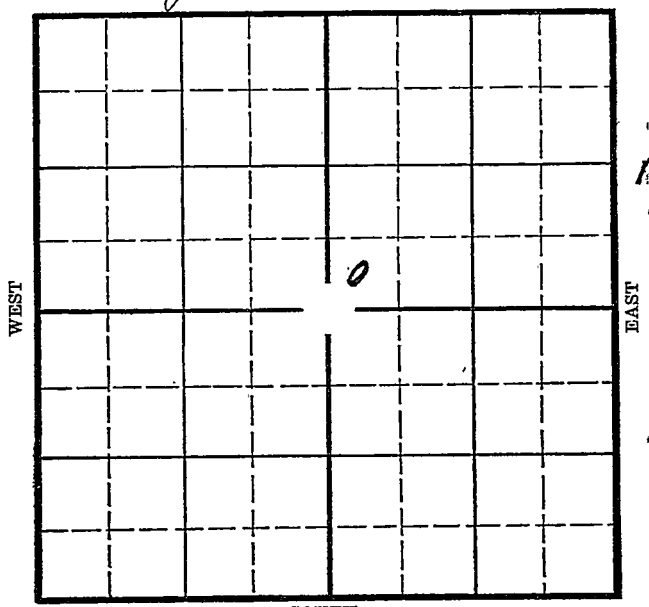

SOUTH

Location \_\_\_\_\_

Drilling Remarks \_\_\_\_\_

\_\_\_\_\_

\_\_\_\_\_

Rig Up \_\_\_\_\_

Drilling Remarks \_\_\_\_\_

\_\_\_\_\_

\_\_\_\_\_

**RECORD**

Cased \_\_\_\_\_ in. \_\_\_\_\_ ft.

Sand \_\_\_\_\_

Gas \_\_\_\_\_

Oil \_\_\_\_\_

Total Depth \_\_\_\_\_

**PRODUCTION**

1st 24 hrs. Nat. \_\_\_\_\_

1st 24 hrs. after shot \_\_\_\_\_

Gas \_\_\_\_\_ cu. ft. \_\_\_\_\_

Dry Hole \_\_\_\_\_


Abandoned \_\_\_\_\_

Rooke

Map No. KANSAS Sec. 31 Twp. 10 R. 16<sup>w</sup>

Well No. 1-Bradley Farm  
Slack, Pryor & Lockhart Company

\_\_\_\_\_ Ft. from N. Line  
330 Ft. from S. Line  
\_\_\_\_\_ Ft. from E. Line  
330 Ft. from W. Line

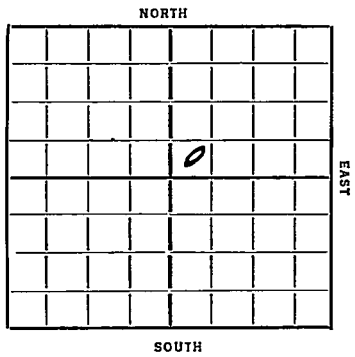

Elev. 1981

REPORT

Date	Location	
12/11	Location	
12/19	4m I rig	
12/26	Riv	
1/2/36	Spud	
1/19	Dlg 556	
1/17	SD 625	
1/24	Dlg 855	15" 579
1/31	Top Archy 1150	13" 1151
	Dlg 1510	
2/7	" 2210	
2/14	10" 2339	Sho Flat 2339-42
	Dlg 2525	
2/21	8" 2703	TD 2730 WR 8"
2/28	WR 8" 3060	
3/6	8" 3060 Dlg	
3/13	6" 3120	Dev 3166
	Sho Oil 3187	TD WR 6"
3/20	Sho oil 3338-47	T. cong. 3456.
	Drlg 3502	
3/27	T.D. 3502	fishing.
4/2	Drlg. 3605'	
4/10	S.D.	

(OVER)

4/15 Ail 3658

TD 3701

HFW

D & A.

ABANDONED

Map No. 64 Sec. 31 Twp. 10 R. 16W

Well No. 1 - Bradley

Slick - Pryor & Lockhart Company

Contractor

Sw 7th

SECTION PLAT

		0	

..... Ft. from N. Line

330 Ft. from S. Line

..... Ft. from E. Line

330 Ft. from W. Line

RECORD

Location /.....

Cased..... in., ..... ft.

Rig up.....

Sand.....

Drilling and Remarks:

Gas.....

Oil.....

Total Depth.....

PRODUCTION

1st 24 hrs. Nat.....

1st 24 hrs. after shot.....

Gas..... Cu. Ft.

Dry Hole.....

Abandoned.....

Date

12-11-35 192..... Scout

Map No. 64 Sec. 31 Twp. 10 R. 16 W

Well No. 1 Bradley

Blick, Papp & Lockhart company  
Contractor

SECTION PLAT

		0	

..... Ft. from N. Line

230 Ft. from S. Line

..... Ft. from E. Line

330 Ft. from W. Line

ABANDONED

Location.....

Rig up.....

Drilling and Remarks:

Sil 3658

HPW

JJA

RECORD

Cased..... in., ..... ft.

Sand.....

Gas.....

Oil.....

Total Depth 3701

PRODUCTION

1st 24-hrs. Nat.....

1st 24 hrs. after shot.....

Gas..... Cu. Ft.

Dry Hole.....

Abandoned.....

Date

APR 15 1936

S. J. LEWIS

192.....

Scout